
PLAT OF SURVEY

Note:

- O IRON PIPE FOUND
- IRON ROD FOUND
- () MEASURED AS

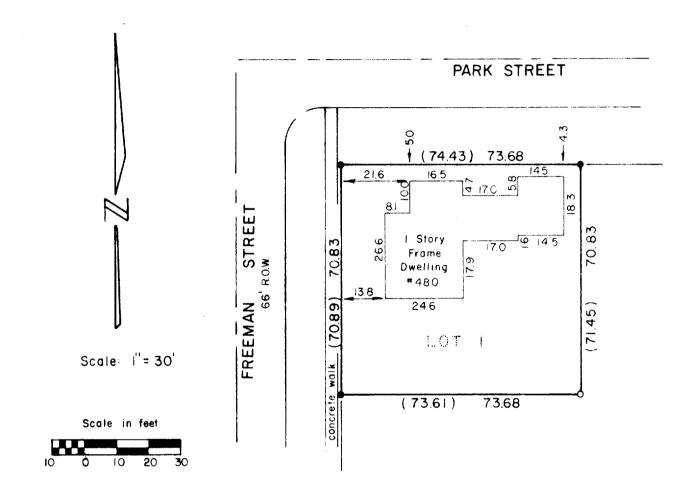

DESCRIPTION:

A part of Lot 1 of Freeman's Addition to the Village of Genoa City, Walworth County, Wisconsin according to the recorded Plat thereof described as follows: Commencing at the NW Corner of said Lot 1, thence South along the west lot line 70.83 feet, thence East 73.68 feet, thence North 70.83 feet to the north line of said Lot 1, thence West 73.68 feet to the point of beginning.

SURVEYOR'S CERTIFICATE

I have surveyed the above described property and the above map is a true representation thereof and shows the size and location of the property, its exterior boundaries, the location and dimensions of all visible encroach ments. This survey is made for the exclusive use of the present owners of the property, and also those who purchase, mortgage, or guarantee the title thereto within one (1) year from date hereof and as to them I warrant the accuracy of said survey and map.

Prepared By VALENTINE AND ASSOCIATES, INC. DELAVAN, WISCONSIN

Prepared For

WILLIAM VAN DER ZEE GENOA CITY, WISCONSIN

Sheet Number Date 3/17/78 of | Job Number

Reference 7823 FILE

TFR-1