


PLAT OF SURVEY OF


Lot 9, Block 1 of GIFFORD'S ADDITION TO THE VILLAGE OF GENOA JUNCTION, being a subdivision of part of the Northeast Quarter of Section 35, Township 1 North, Range 18 East of the 4th Principal Meridian, now the Village of Genoa City, Walworth County, Wisconsin.



FRANKLIN STREET 66' R/W

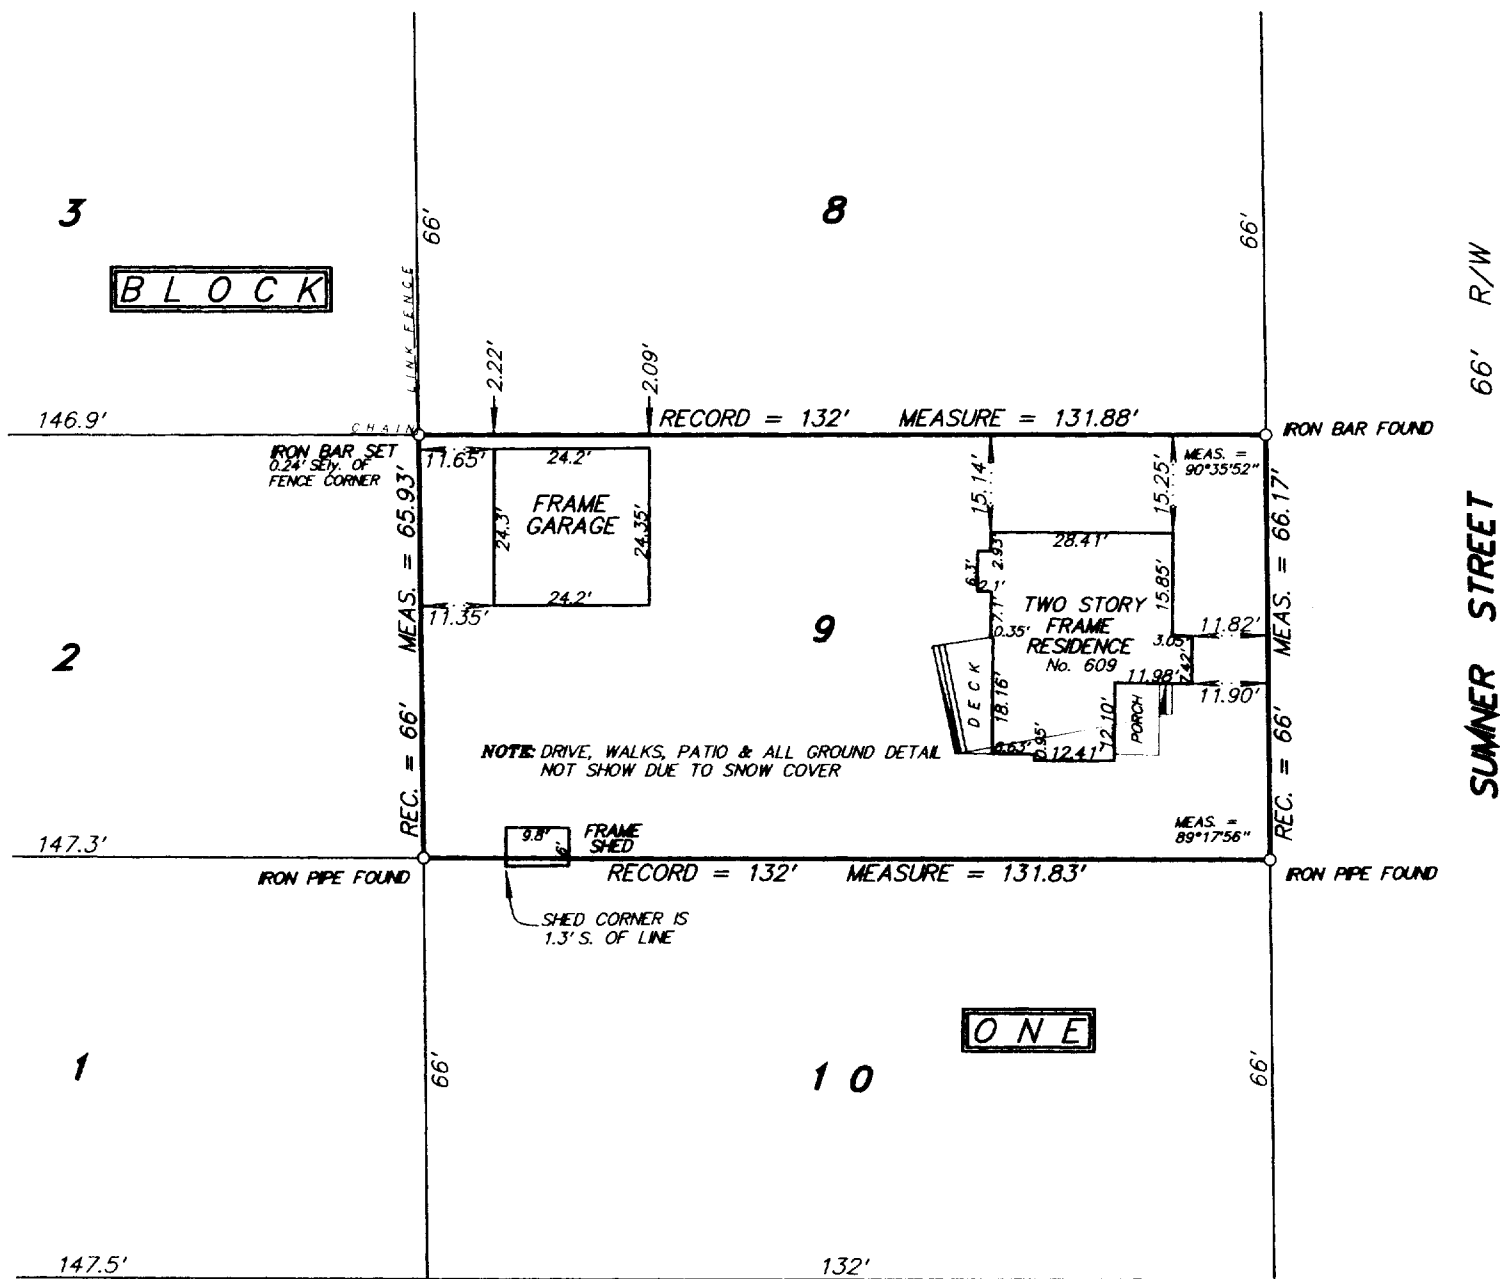

SCALE 1 inch = 30 feet
ORDERED BY K. Esmond
JOB NO. 03027

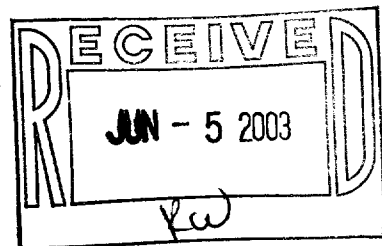

I hereby certify that I have surveyed the above described property and the above plat is a true representation thereof and shows the size and location of the property, its exterior boundaries, the location and dimensions of all visible structures thereon, boundary fences, apparent easements and roadways and visible encroachments, if any.

This survey is made for the exclusive use of the present owners of the property, and also those who purchase, mortgage, or guarantee the title thereto within one year from the date hereof.

Dated at Bassett, Wisconsin this _____ day of _____ 2003.

Mark A. Bolender
Wisconsin Registered Land Surveyor S - 1784