


A piece or parcel of land situated in the Village of Genoa City, Walworth County, Wisconsin, legally described as: Beginning 3 chains or 12 rods (198 feet) North of a point where Freeman Street intersects the East and West 1/4 line of Section 35, Township 1 North, Range 18 East, thence 1 chain North (66 feet), thence 2 chains West (132 feet), thence 1 chain South (66 feet), thence 2 chains East (132 feet), to the place of beginning.

Legal description from Quit Claim Deed, Document No. 0552047



Parcel Identification Number (PIN): TVGC 00032

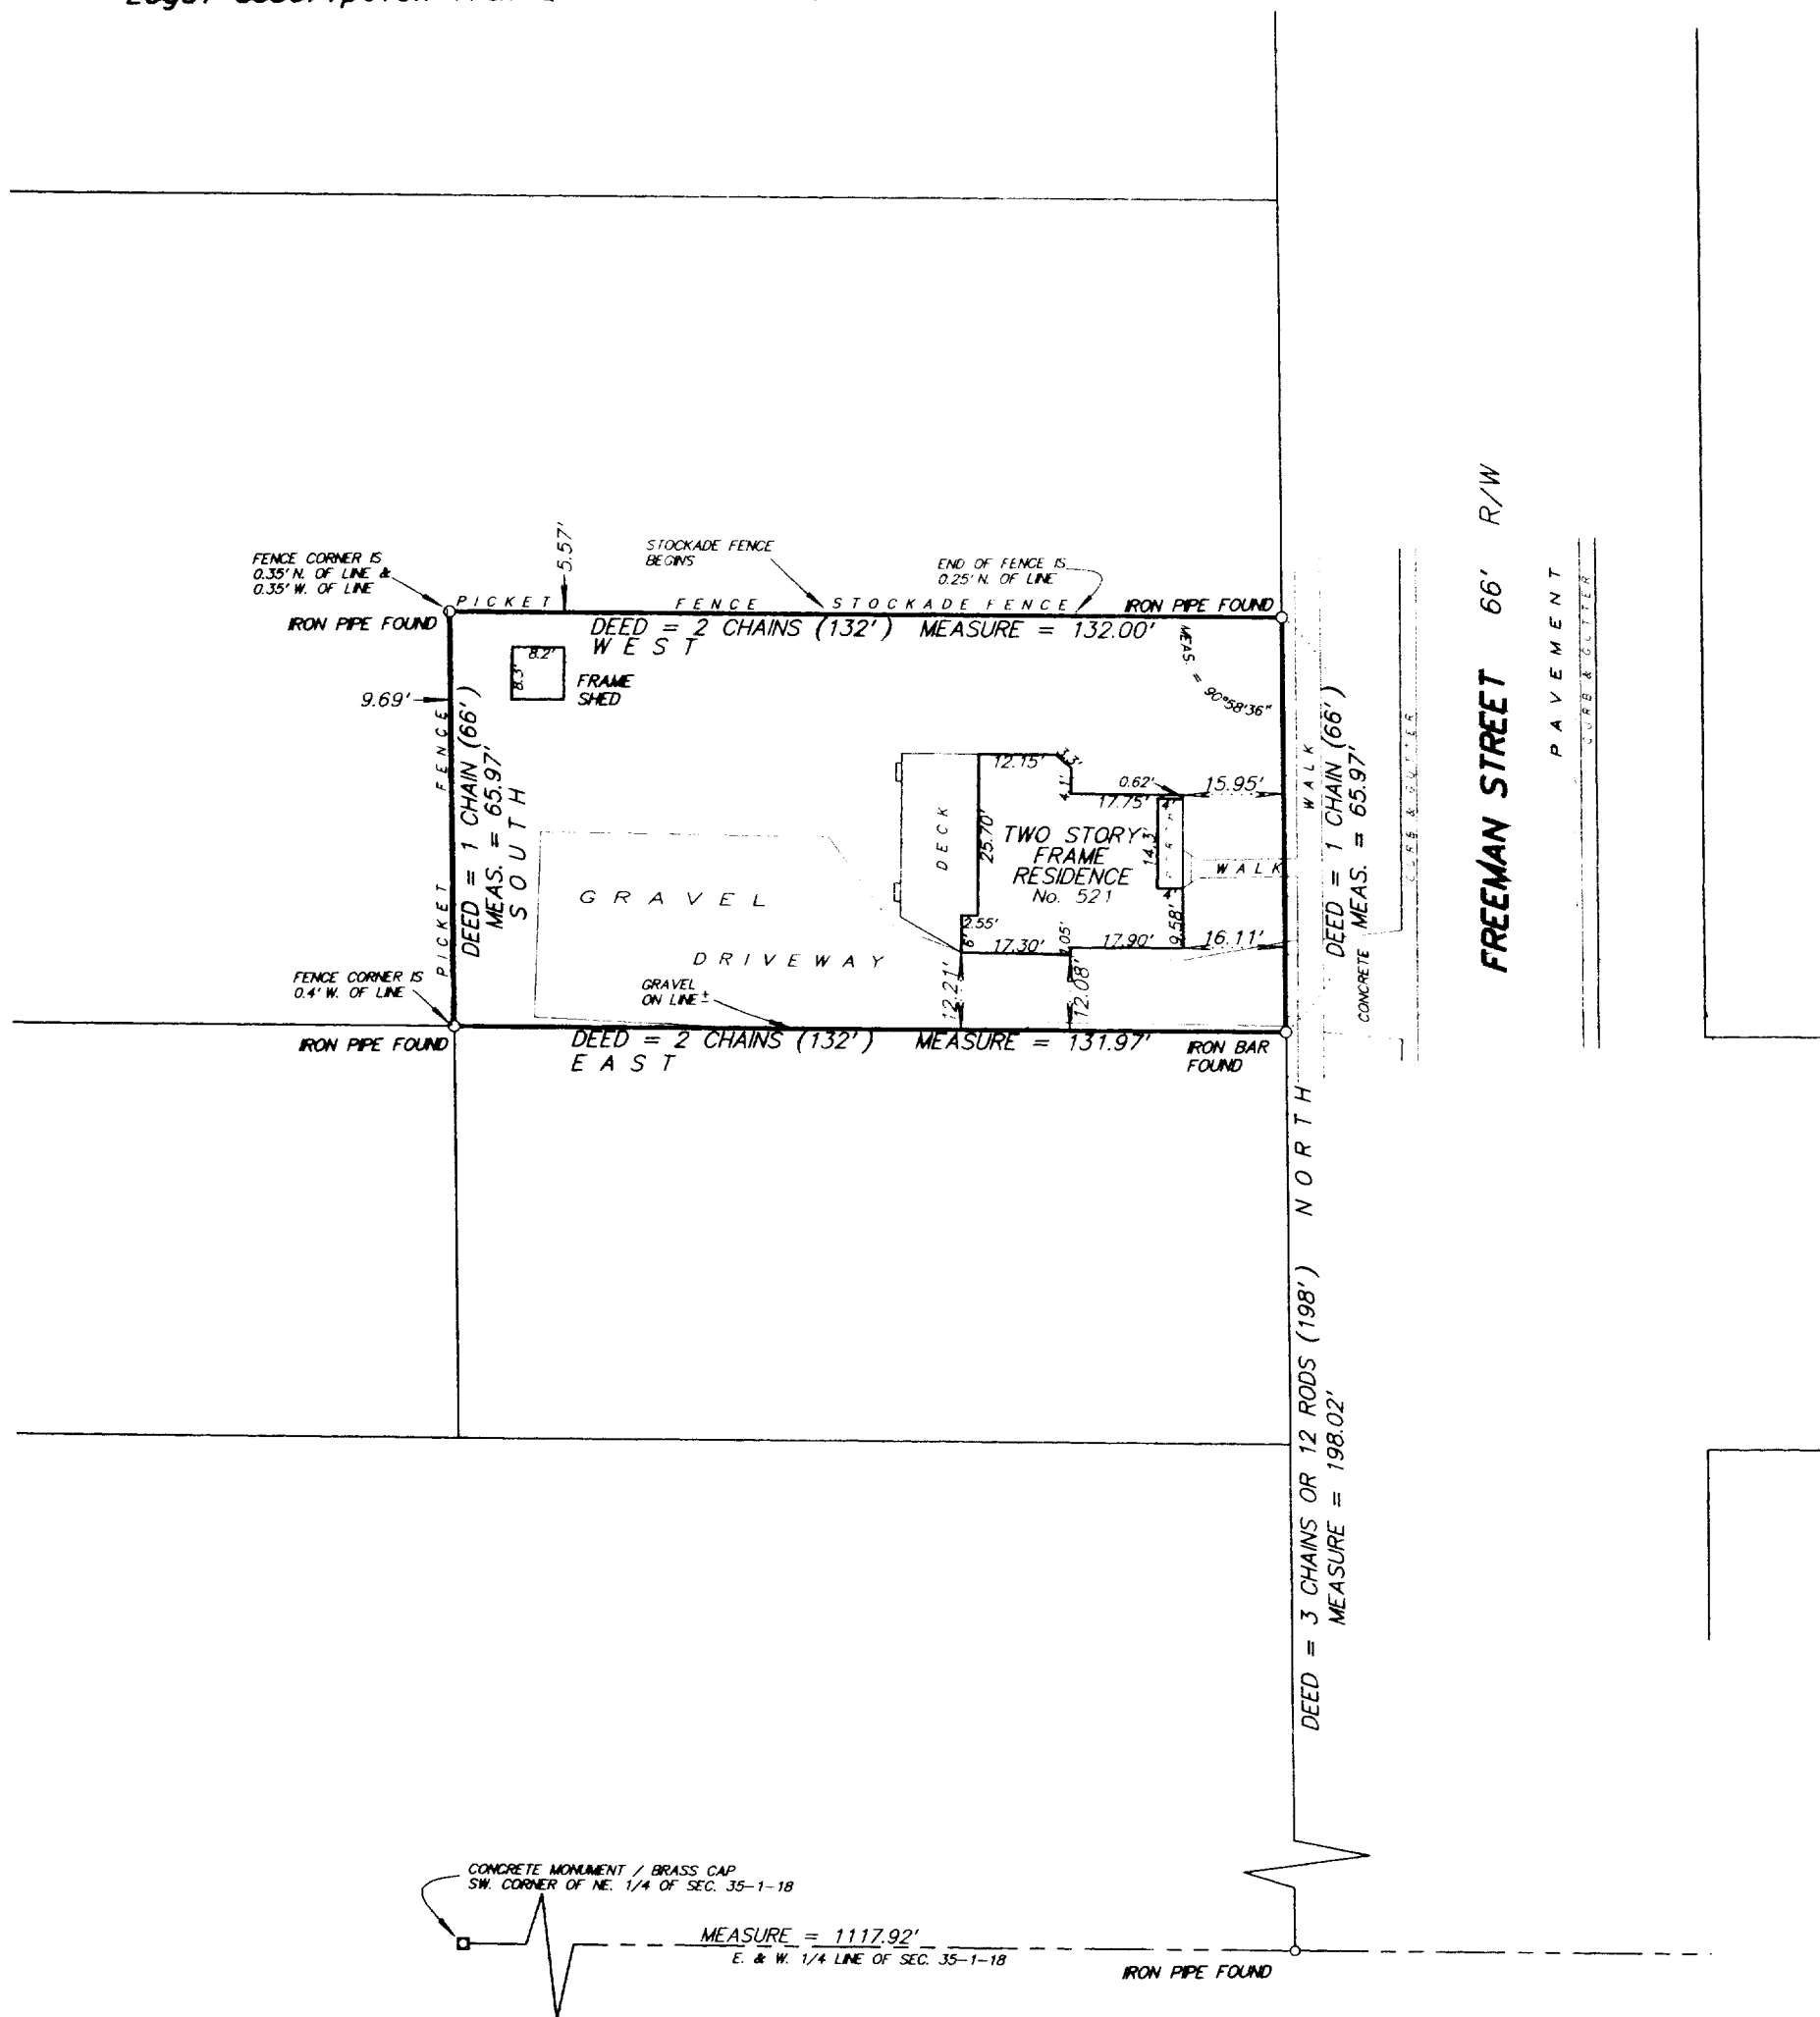

SCALE 1 inch = 30 feet

ORDERED BY F. Lentz

JOB NO. 03082

I hereby certify that I have surveyed the above described property and the above plat is a true representation thereof and shows the size and location of the property, its exterior boundaries, the location and dimensions of all visible structures thereon, boundary fences, apparent easements and roadways and visible encroachments, if any.

This survey is made for the exclusive use of the present owners of the property, and also those who purchase, mortgage, or guarantee the title thereto within one year from the date hereof.

Dated at Bassett, Wisconsin this _____ day of _____ 2003.

Mark A. Bolender
Wisconsin Registered Land Surveyor S - 1784

