
 
## KOLB LAND CONSULTING, INC.

LAKE GENEVA, WISCONSIN

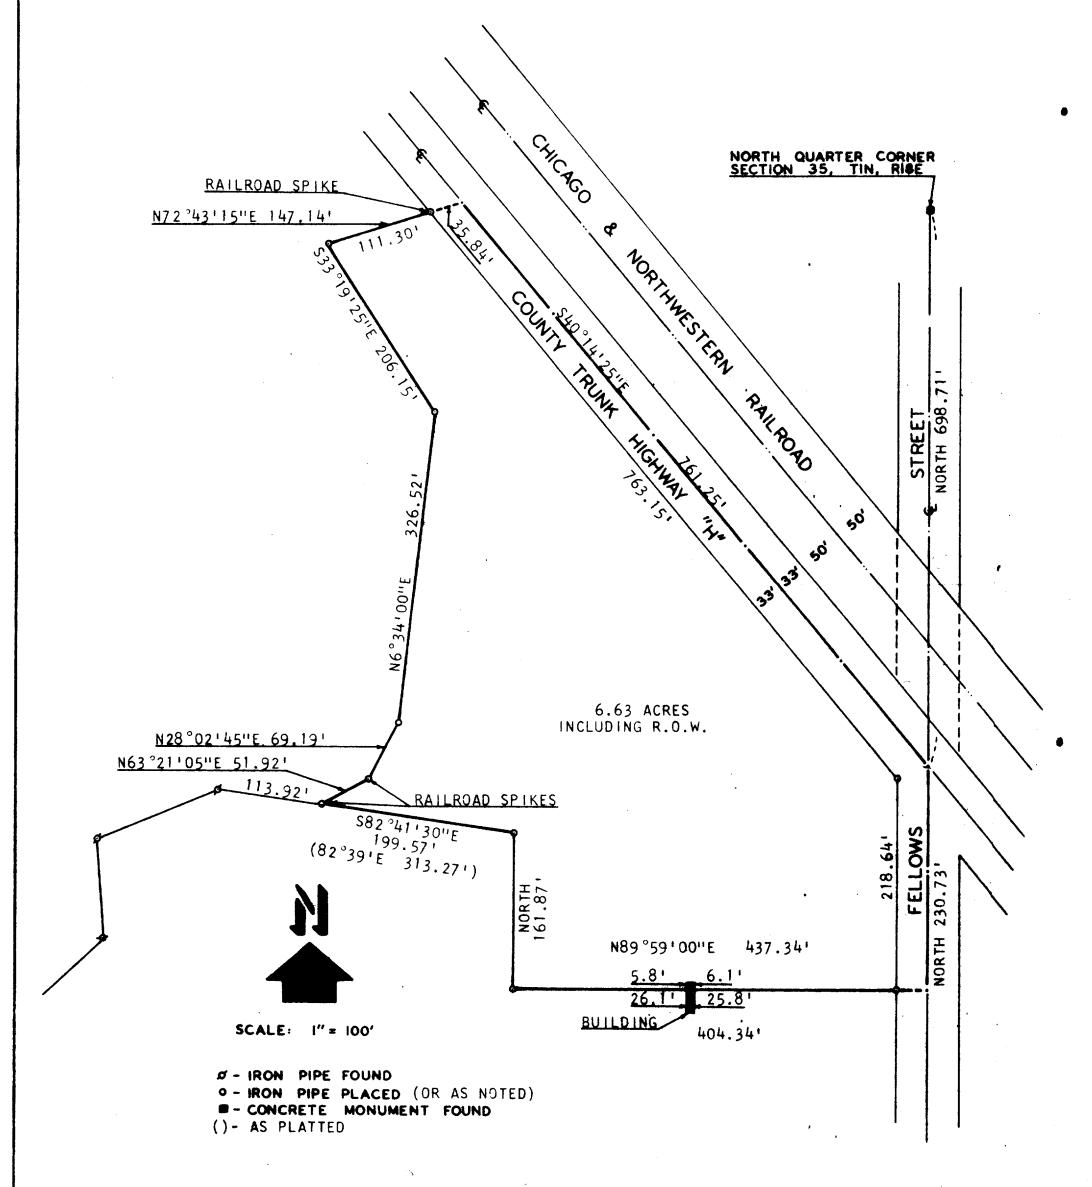



A PARCEL OF LAND LOCATED IN THE NORTHWEST \$\frac{1}{4}\$ OF SECTION 35, T 1 N, R 18 E, VILLAGE OF GENOA CITY, WALWORTH COUNTY, WISCONSIN, AND DESCRIBED AS FOLLOWS: COMMENCING AT THE NORTH \$\frac{1}{4}\$ CORNER OF SAID SECTION 35, THENCE SOUTH 698.71 FEET TO THE PLACE OF BEGINNING; THENCE CONTINUE SOUTH 230.73 FEET; THENCE \$89°59'00"W 437.34 FEET; THENCE NORTH 161.87 FEET; THENCE \$82°41'30"W 199.57 FEET; THENCE \$63°21'05"E 51.92 FEET; THENCE \$82°41'30"W 199.57 FEET; THENCE \$63°21'05"E 51.92 FEET; THENCE \$82°45"E 69.19 FEET; THENCE \$634'00"E 326.52 FEET; THENCE \$83°19'25"W 206.15 FEET; THENCE \$634'00"E 326.52 FEET; THENCE \$60°14'25"E 761.25 FEET TO THE PLACE OF BEGINNING. CONTAINING 6.63 ACRES INCLUDING ROAD RIGHT-OF-WAY.

I, HAROLD H. KOLB, DO HEREBY CERTIFY THAT I HAVE SURVEYED THE PROPERTY HEREON DESCRIBED ACCORDING TO THE OFFICIAL RECORDS, AND THAT THE PLAT HEREON IS A CORRECT REPRESENTATION OF THE LOT LINES.



DATE Dec. 2), 1978

