

PLAT OF SURVEY

- OF -

BOOTH STREET

SUMNER STREET

(66' WIDE)

(132.00')

N 89°48'00" E 131.40'

(N 00°05'00" E 66.40')
(N 00°12'30" E 66.29')

15.74'

32.53'

9.55'

13.12'

13.45'

9.45'

28.45'

19.00'

13.45'

EXISTING RESIDENCE

CONCRETE WALK

CONCRETE DRIVE

CONCRETE GARAGE

18.42'

22.41'

6.71'

17.70'


(S 00°06'32" W 66.57')
(S 00°05'00" W 66.40')


S 89°55'28" W 131.52'
(S 89°48'00" W 132.00')

LOT 2
BLOCK 4

"I hereby certify that I have surveyed the above described property and that the above map, to the best of my knowledge and belief, is a true representation thereof and shows the size and location of all visible structures, apparent easements and encroachments if any."

RECEIVED
AUG 13 2004
KW

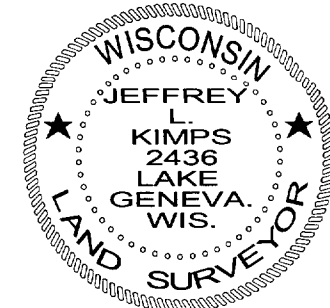


JEFFREY L KIMPS S - 2436
Wisconsin Registered Land Surveyor
(original if signed in red)

DATED THIS 13TH DAY OF MAY, 2004

() = RECORDED AS
 □ = FOUND IRON BAR
 ○ = FOUND IRON PIPE
 ■ = SET IRON BAR
 ● = SET IRON PIPE
 SCALE: 1" = 20'
 JOB #: 04-214
 TAX ID #: TFR2 00010

006-1186