
GEORGE T. DUNHAM SURVEYING & SURDIVIDING DELAVAN, WISCONSIN'

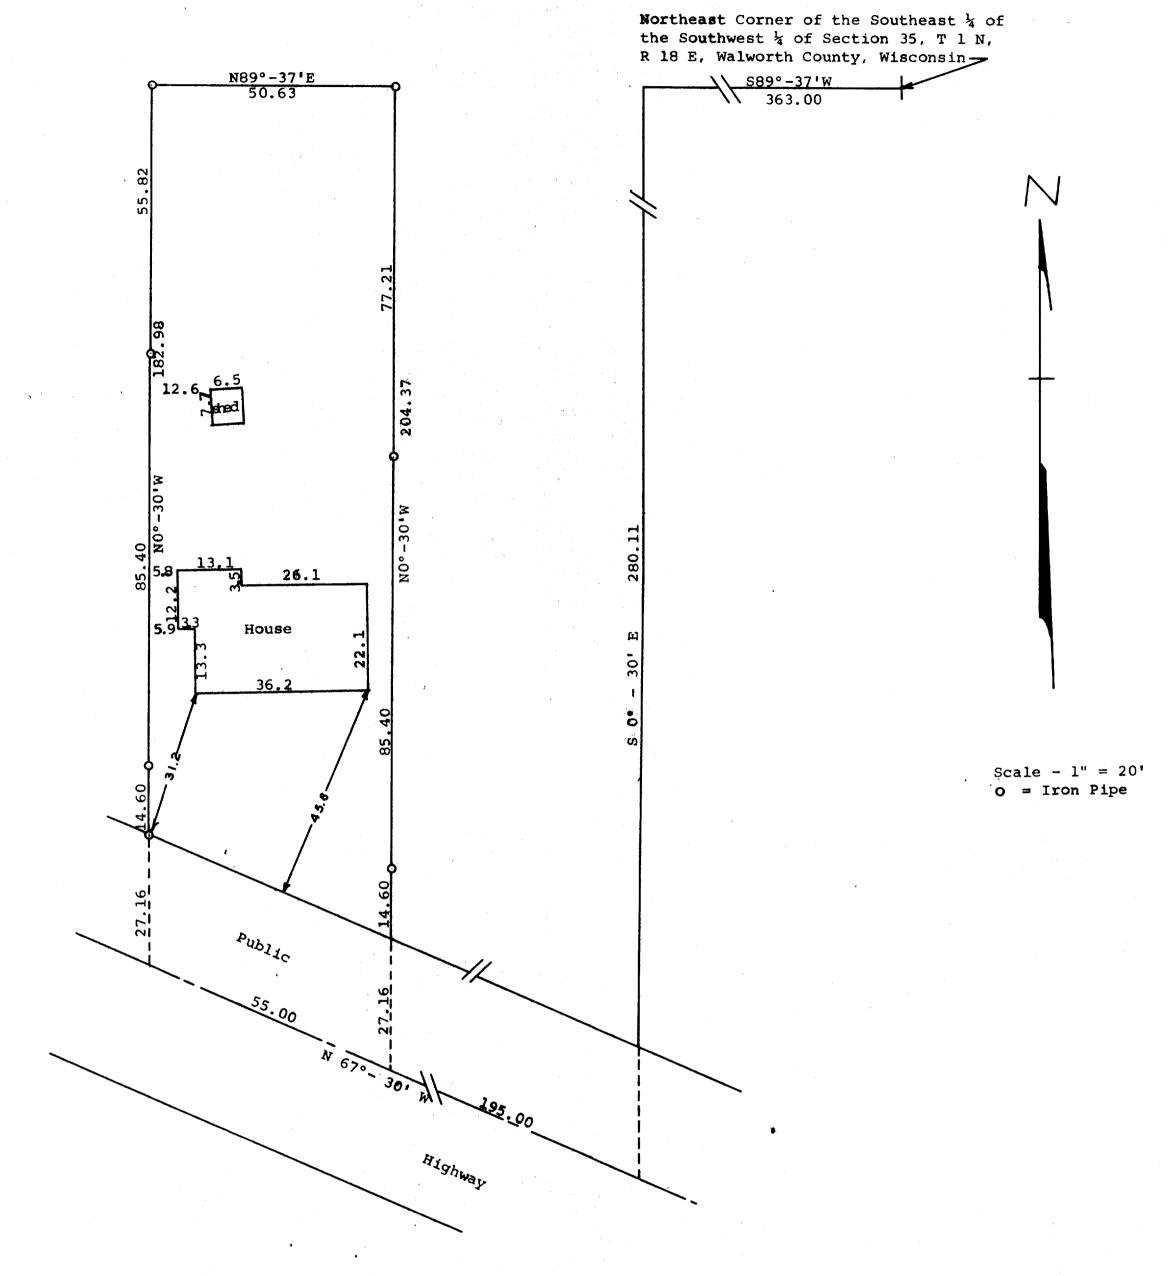

STATE OF WISCONSIN) SS COUNTY OF WALWORTH)

I, George T. Dunham, Surveyor, certify that I have surveyed the property described as follows,

A parcel of land located in the Southeast & of the Southwest & of Section 35, T l N, R l8 E of Walworth County, Wisconsin, described as follows, to-wit: Commencing at the northeast corner of the Southeast & of the Southwest & of said Section 35; thence S 89° - 37' W along the 1/8th section line 363 feet; thence S 0° - 30' E 280.11 feet; thence N 67° - 30' W along the centerline of said highway 195.00 feet to the place of beginning; thence continuing N 67° - 30' W 55.00 feet; thence N 0° - 30' W 182.98 feet to the 1/8th section line; thence N 89° - 37' E along the said 1/8th section line 50.63 feet; thence S 0° - 30' E 204.37 feet to the place of beginning.

S 0° - 30' E 204.37 feet to the place of beginning.

and that the plat shows above is an accurate survey and a true representation thereof and correctly shows the exterior boundary lines and location of buildings on said property and the correct measurements thereof.

June 24, 1969

Jerry & Dunkam, Surveyor

K & E 10-7155 250-3-66