
## FARRIS, HANSEN & ASSOCIATES, INC.

ENGINEERING, ARCHITECTURE, SURVEYING 7 RIDGEWAY COURT - P.O. BOX 437, ELKHORN, WISCONSIN, 53121 PHONE: (262) 723-2098 FAX: (262) 723-5886

## PLAT OF SURVEY

## LOT 228 OF HUNTERS RIDGE SUBDIVISION ADDITION NO. 1

LOCATED IN PART OF THE NW 1/4 & SW 1/4 OF THE NW 1/4 OF SECTION 36, TOWN 1 NORTH, RANGE 18 EAST VILLAGE OF GENOA CITY, WALWORTH COUNTY, WISCONSIN

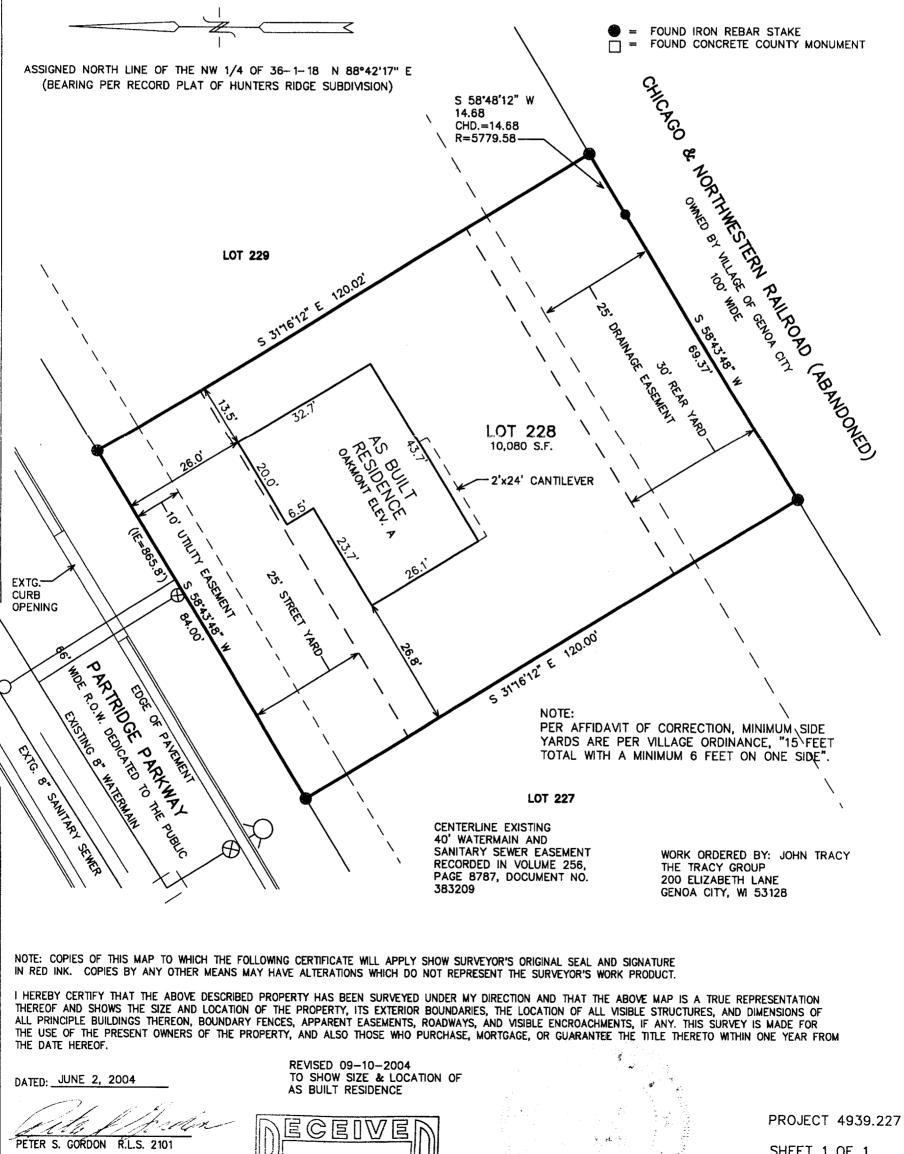

THR1 00029 SEP 10 2004 SED 2 2 2004