LOTS 8 AND 9 OF HORNSBY BUSINESS PARK, BEING PART OF THE NORTHWEST 1/4 OF THE NORTHWEST 1/4 AND THE SOUTHEAST 1/4 OF THE NORTHWEST 1/4 AND THE NORTHWEST 1/4 OF THE SOUTHWEST 1/4 AND THE NORTHEAST 1/4 OF THE SOUTHWEST 1/4 ALL IN SECTION 36, TOWN 1 NORTH, RANGE 18 EAST OF THE FOURTH PRINCIPAL MERIDIAN, VILLAGE OF GENOA CITY, COUNTY OF WALWORTH, STATE OF WISCONSIN. SURVEY FOR: SORENSON DEVELOPMENT

LEGEND

- O FOUND IRON PIPE
- SET IRON PIPE

& EXISTING ELEVATION

SCALE 1" = 50'

CURVE DATA

RADIUS = 330.00' I.A. = 07'49'06"

CHD. = 45.00° CHD. B'ING = $502^{\circ}19'13''W$


"I hereby certify that I have surveyed the above described property and that the above map is a correct representation thereof and shows the size and location of the property, its exterior boundaries, the location of all visible structures and dimensions of all principal buildings thereon, boundary fences, apparent easements, roadways and encroachments, if any."

"This survey is made for the use of the present owners of the property, and those who purchase, mortgage, or guarantee the title thereto within one year from date hereof."



B.W. SURVEYING, INC.

LAND SURVEYS
MAPPING AND PLANNING
412 N. PINE STREET
BURLINGTON, W 53105
(262)-767-0225

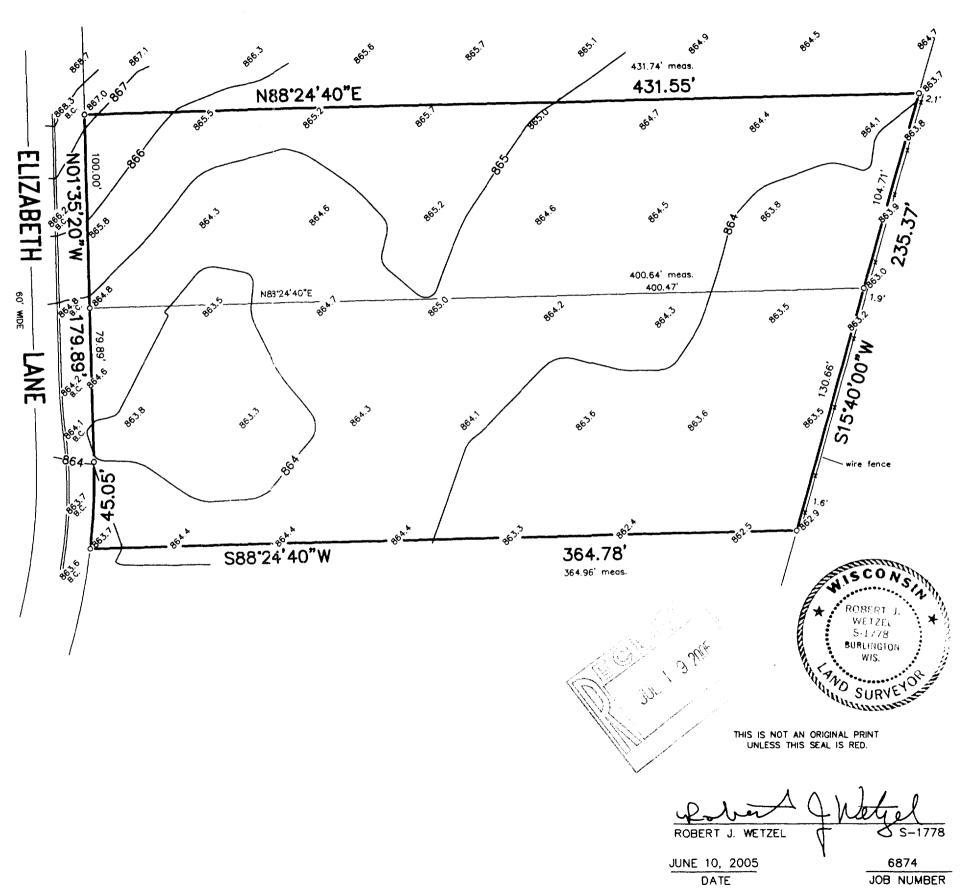

8000 08