

DEGEN-FOAT SURVEYING, INC.  
 100 SOUTH SECOND STREET  
 WATERFORD, WISCONSIN  
 (262)534-5404 (FAX)534-2022


060225  
 060225S1.DWG

PLAT OF SURVEY

LOT 4, BLOCK 2, GIFFORD'S ADDITION TO THE VILLAGE OF GENOA CITY,  
 WALWORTH COUNTY, WISCONSIN

\* REFER TO CURRENT TITLE REPORT FOR EASEMENTS, RESTRICTIONS OR COVENANTS OF RECORD THAT MAY AFFECT THIS LAND \*

SUMNER STREET (66' WIDE)

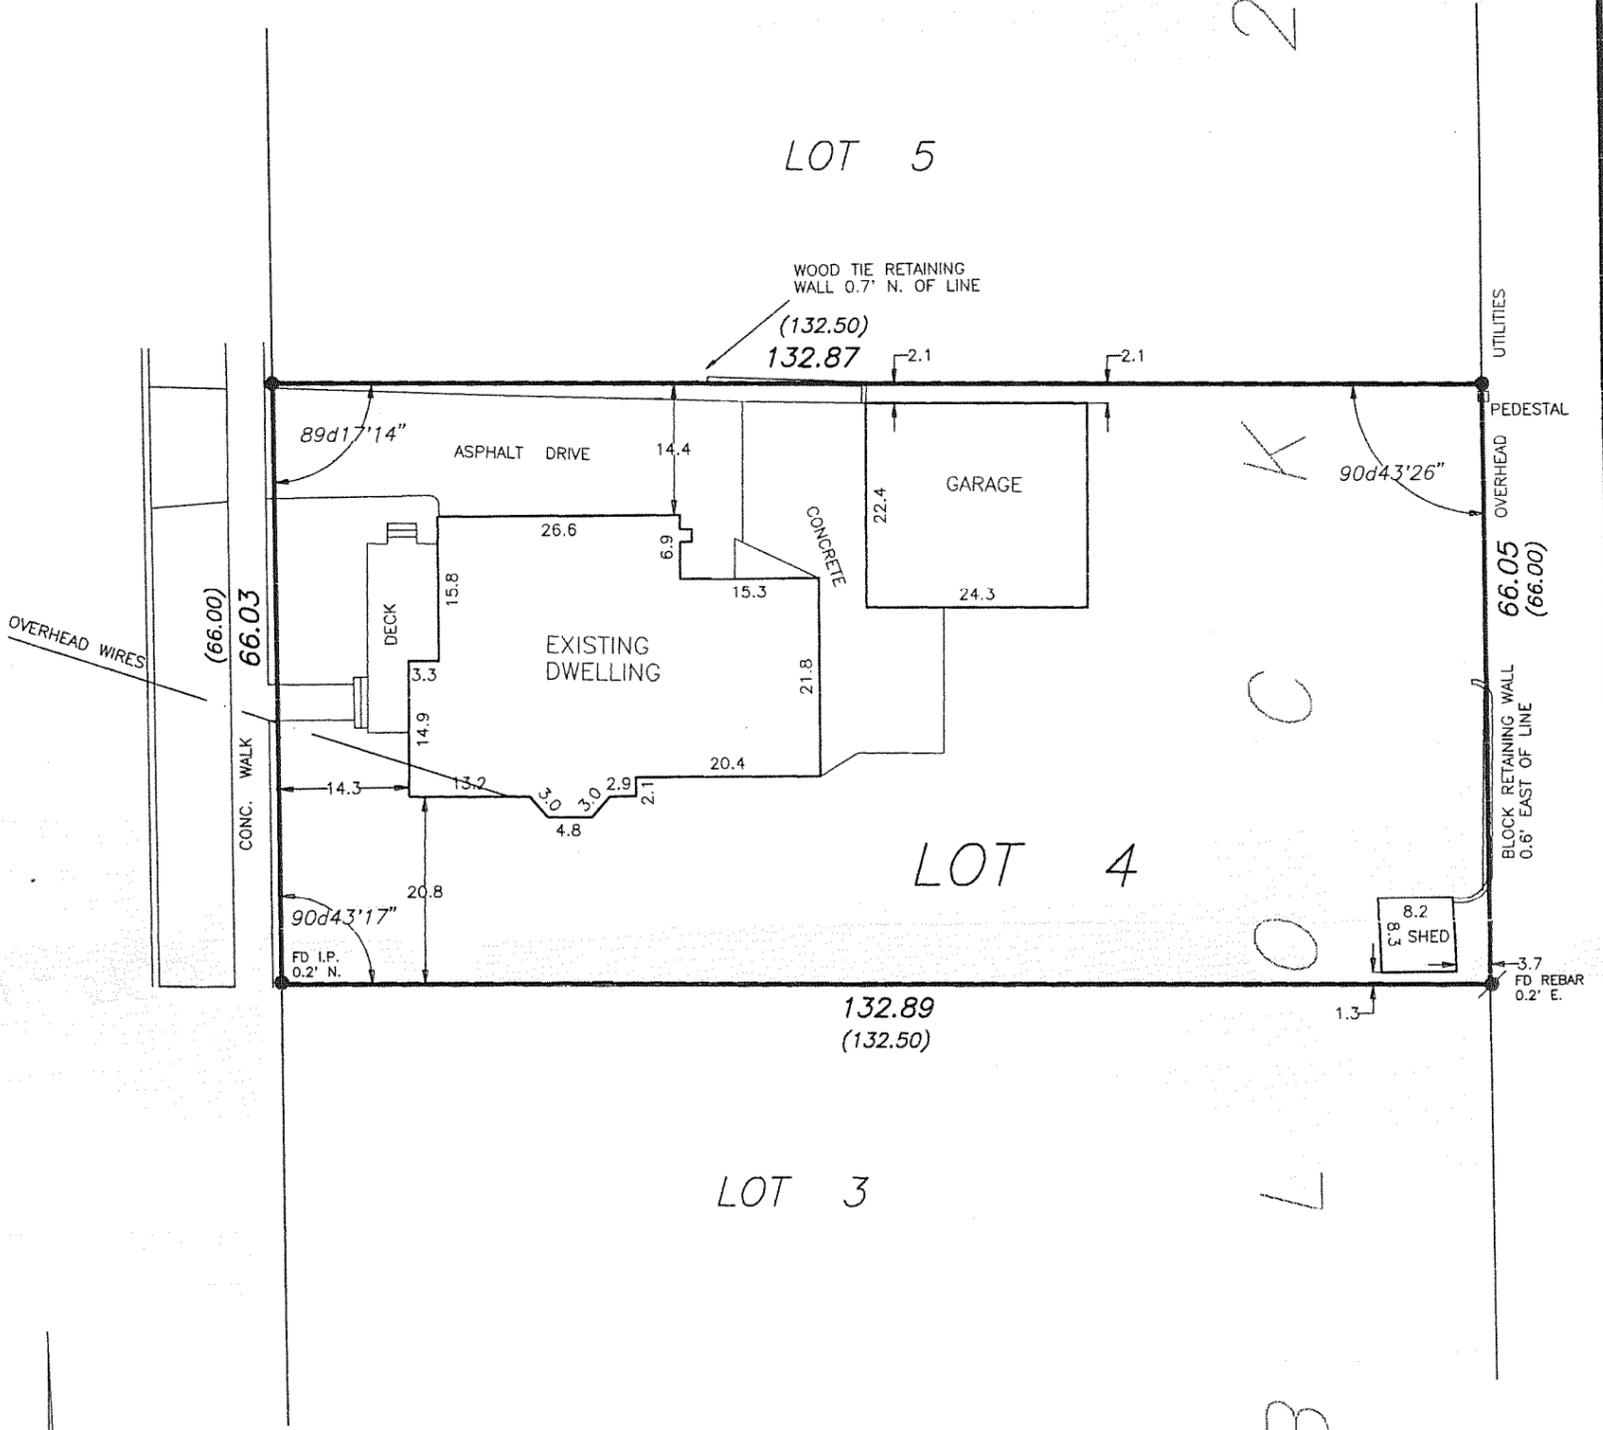



PREPARED FOR: KEEFE REALTY  
 P.O. BOX 460  
 LAKE GENEVA, WI 53128

ORDERED BY: TAMMY HAASE

SCALE: 1" = 20'

LEGEND

- - FOUND IRON PIPE
- ⦿ - FOUND IRON ROD
- - FENCE
- ( ) - RECORDED AS

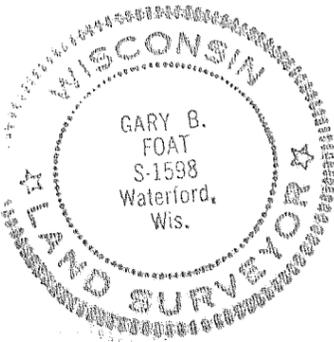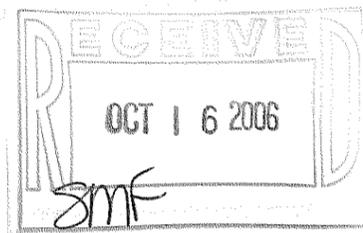

I HEREBY CERTIFY THAT I HAVE SURVEYED THE ABOVE DESCRIBED PROPERTY AND THE ABOVE MAP IS A TRUE REPRESENTATION THEREOF AND SHOWS THE SIZE AND LOCATION OF THE PROPERTY, THE LOCATION OF ALL VISIBLE STRUCTURES AND DIMENSIONS OF ALL PRINCIPAL BUILDINGS THEREON, BOUNDARY FENCES, APPARENT EASEMENTS, ROADWAY AND VISIBLE ENCROACHMENTS, IF ANY.

THIS SURVEY IS MADE FOR THE PRESENT OWNERS OF THE PROPERTY, AND ALSO THOSE WHO PURCHASE, OR GUARANTEE THE TITLE THERETO WITHIN (1) YEAR FROM THE DATE HEREOF.

DATED AT WATERFORD THIS 17th DAY OF AUGUST 20 06

RECERTIFIED \_\_\_\_\_

*Gary B. Foat*

006-1239

TG-14