KOLB LAND CONSULTING, INC.

LAND SURVEYING . SUBDIVIDING . LAND PLANNING

LAKE GENEVA, WISCONSIN 53147

WHITEWATER, WISCONSIN 53190

POINT DESCRIBED AS NW CORNER OF SW 4 OF SW 4 OF SECTION 36-1-18


66' (4 Rods)



SCALE: 1"=30'

• UTILITY POLE

NOTE: THE PLACEMENT OF MONUMENTS HAS BEEN WAIVED BY THE CLIENT AS PERMITTED IN A-E 5.01(B).

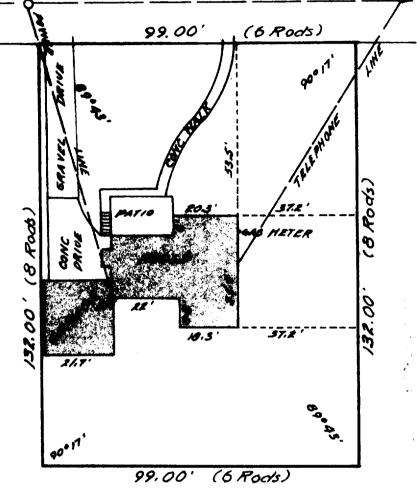

PLAT OF SURVEY OF

A PARCEL OF LAND LOCATED IN THE SOUTHWEST 1/4 OF THE SOUTHWEST 1/4 OF SECTION 36, T 1 N, R 18 E, VILLAGE OF GENOA CITY, WALWORTH COUNTY, WISCONSIN.

ORDERED BY: I D L MORTGAGE CORPORATION P.O. BOX 1256 KENOSHA, WI. 53141



I HEREBY CERTIFY THAT. I HAVE SURVEYED THE ABOVE DESCRIBED PROPERTY AND THAT THE ABOVE MAP IS A TRUE REPRESENTATION THEREOF AND SHOWS THE SIZE AND LOCATION OF THE PROPERTY, ITS EXTERIOR BOUNDARIES, THE LOCATION OF ALL VISIBLE STRUCTURES AND DIMENSIONS OF ALL PRINCIPAL BUILDINGS THEREON, BOUNDARY FENCES, APPARENT EASEMENTS, ROADWAYS AND VISIBLE ENCROACHMENTS, IF ANY.

THIS SURVEY IS MADE FOR THE USE OF THE PRESENT OWNERS OF THE PROPERTY, AND ALSO THOSE WHO PURCHASE, MORTGAGE, OR GUARANTEE THE TITLE THERETO WITHIN ONE (1) YEAR FROM THE DATE HEREOF.

Harold W. Roll

WISCONSIN REGISTERED LAND SURVEYOR, S-187 DATE FEB. 14, 1983