


DEGEN-FOAT SURVEYING, INC.
100 SOUTH SECOND STREET
WATERFORD, WISCONSIN
(262)534-5404 (FAX)534-2022

071019
071019S1.DWG

PLAT OF SURVEY


LOT 2, OF CERTIFIED SURVEY MAP NO. 2193, AS RECORDED IN VOLUME 10 OF CERTIFIED SURVEYS ON PAGE 281, AS DOCUMENT NO. 239862, BEING A PART OF LOTS 5, 8 AND 9, BLOCK 2, J.H. ROWE'S ADDITION TO THE VILLAGE OF GENOA CITY, ACCORDING TO THE RECORDED PLAT THEREOF. SAID LAND BEING IN THE VILLAGE OF GENOA CITY, COUNTY OF WALWORTH AND STATE OF WISCONSIN.

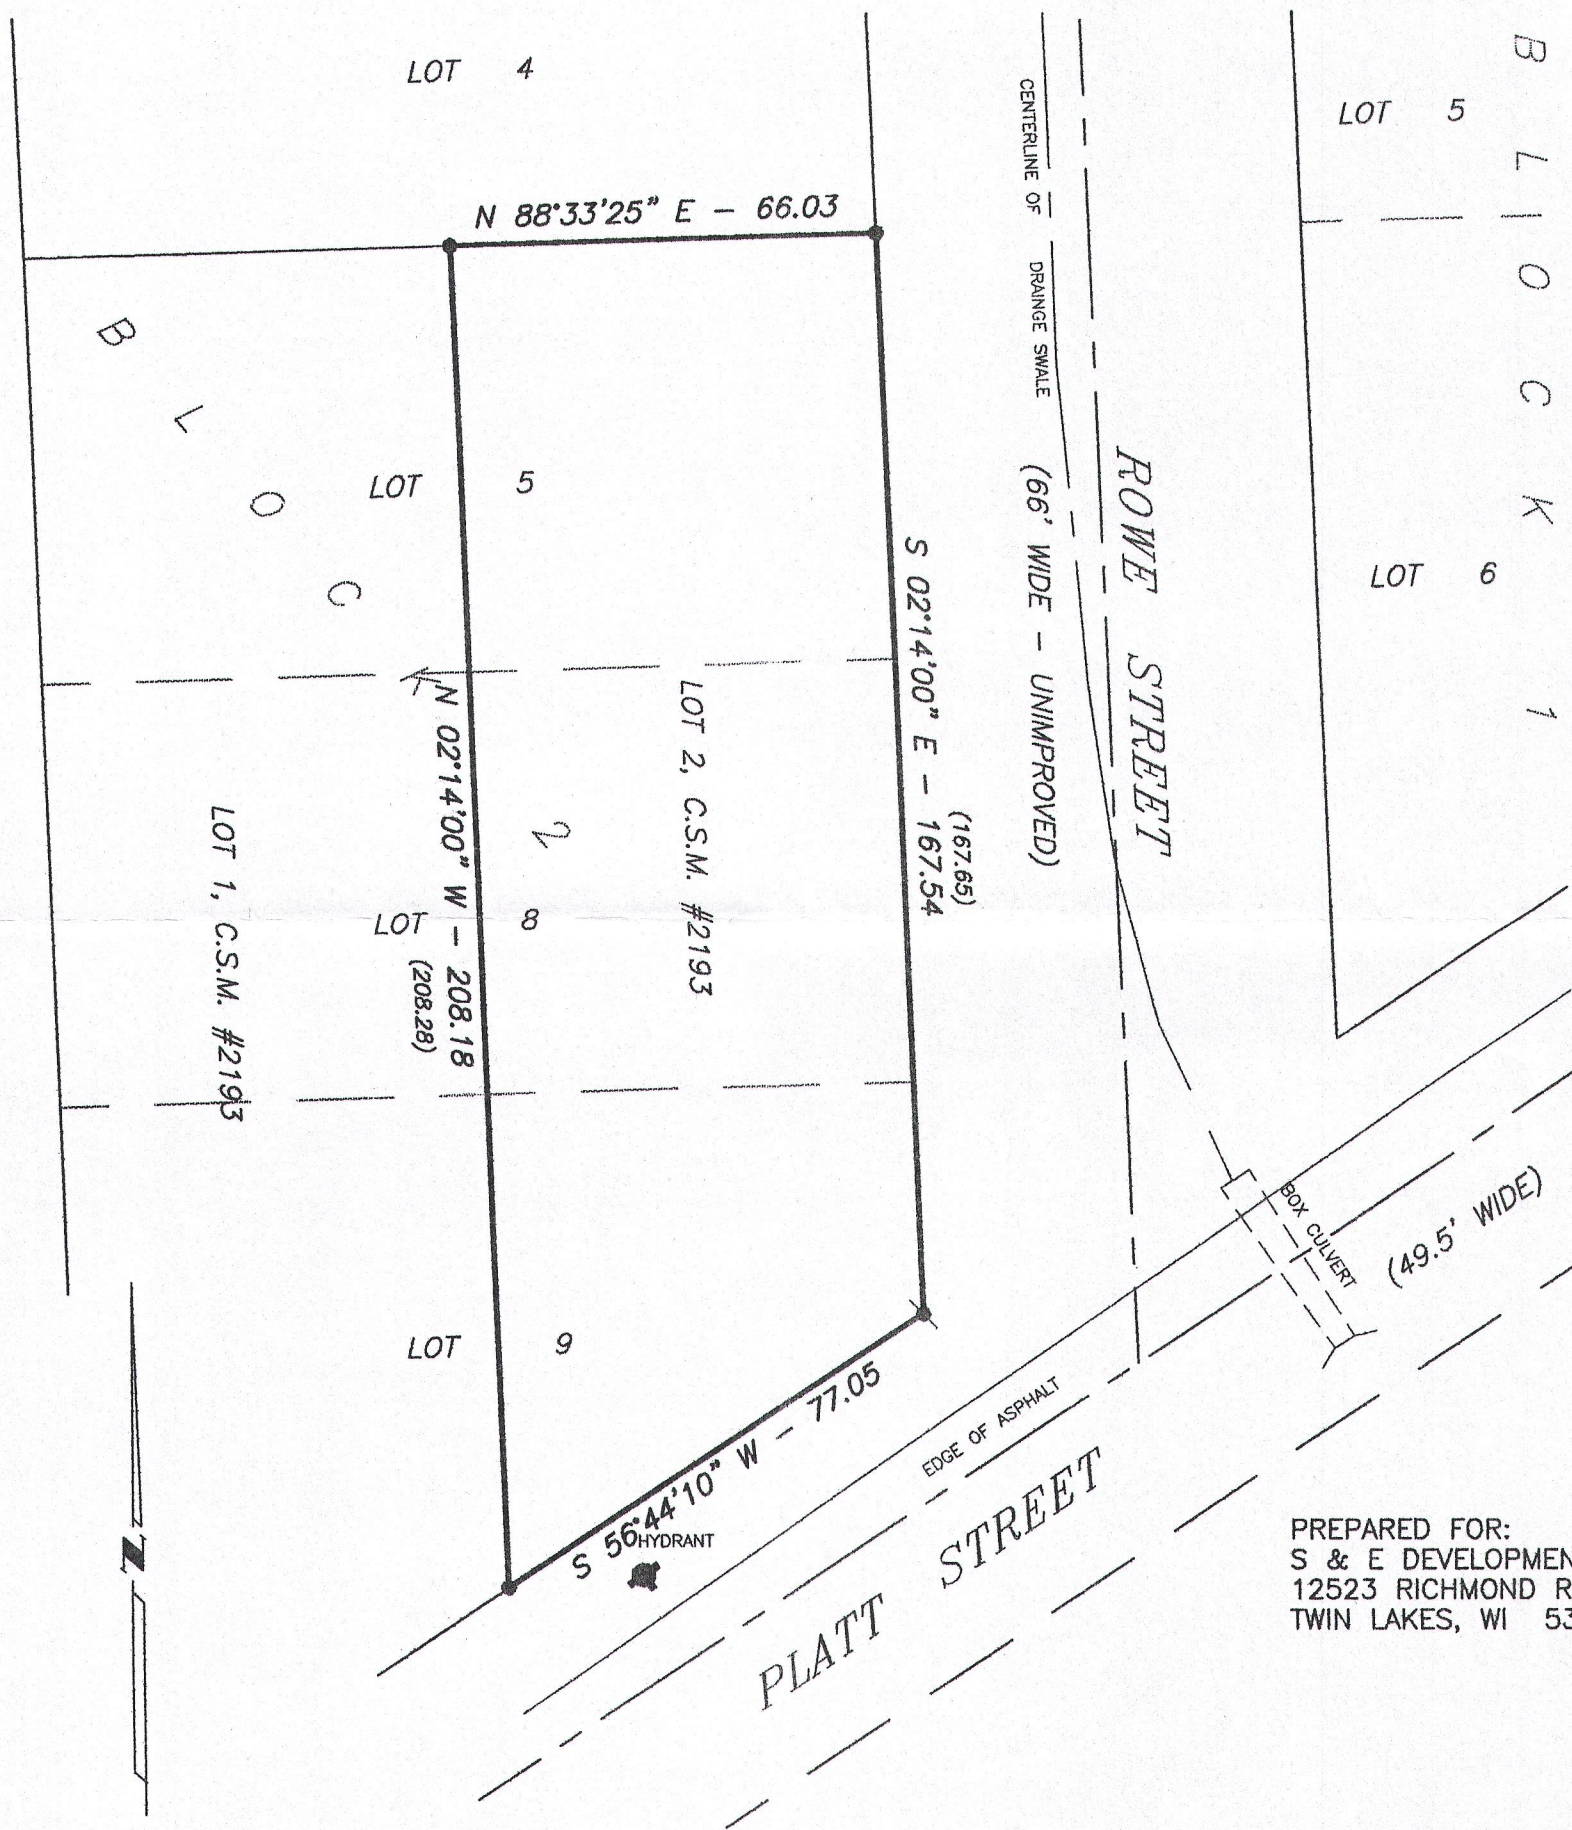

BEARINGS RELATE TO THE EAST LINE OF C.S.M. NO. 2193 WHICH IS RECORDED AS S 2°14'00" E.

LEGEND

- FOUND REBAR
- FOUND IRON PIPE
- () - RECORDED AS

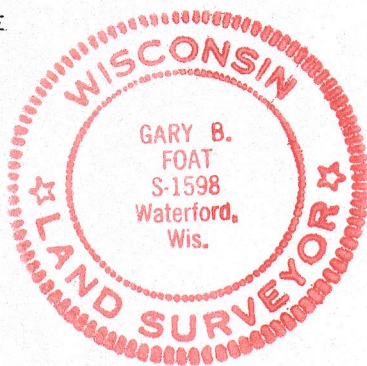

I HEREBY CERTIFY THAT I HAVE SURVEYED THE ABOVE DESCRIBED PROPERTY AND THE ABOVE MAP IS A TRUE REPRESENTATION THEREOF AND SHOWS THE SIZE AND LOCATION OF THE PROPERTY, THE LOCATION OF ALL VISIBLE STRUCTURES AND DIMENSIONS OF ALL PRINCIPAL BUILDINGS THEREON, BOUNDARY FENCES, APPARENT EASEMENTS, ROADWAY AND VISIBLE ENCROACHMENTS, IF ANY.

THIS SURVEY IS MADE FOR THE PRESENT OWNERS OF THE PROPERTY, AND ALSO THOSE WHO PURCHASE, OR GUARANTEE THE TITLE THERETO WITHIN (1) YEAR FROM THE DATE HEREOF.

DATED AT WATERFORD THIS 29th DAY OF January 20 07 Revised: Sept. 26, 2016
CORRECTED PLAT - ROWE ST. WAS NEVER DISCONTINUED

