

ROBERS & BOYD, INC.

CONSULTING ENGINEERS LAND SURVEYORS


109 SOUTH SPRING STREET BURLINGTON, WISCONSIN 53105 PHONE: 414-763-7834

PLAT OF SURVEY FOR FIRST STATE SAVINGS OF

Lot 2, Block 1, Strain's Addition, Village of Genoa City, Walworth County, Wisconsin.

BUYER: Greg K. Koehn and Cathy S. Koehn

209 Wisconsin Street Genoa City, WI 53128

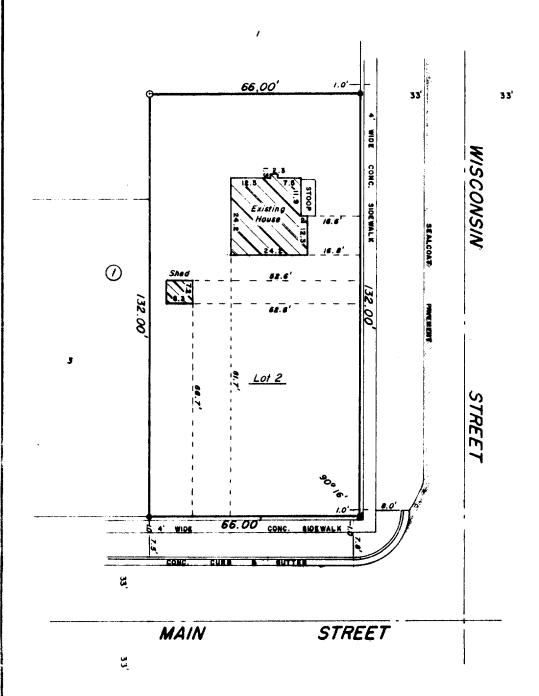

"I hereby certify that I have surveyed the above described property and that the above map is a true representation thereof and shows the size and location of the property, its exterior boundaries, the location of all visible structures and dimensions of all principal buildings thereon, boundary fences, apparent easements, roadways and visible encroachments, if any

"This survey is made for the use of the present owners of the property, and also those who purchase, mortgage, or guarantee the title thereto within one year from date hereof."

NO MONUMENTATION HAS BEEN WAIVED IN ACCORDANCE WITH A-E 5.01(b) OF THE WISCONSIN ADMINISTRATIVE CODE.

REESH.
S-1351
BURLINGTON
WIS.
SURVEYOR

LEGEND CHISEL GUT IN CONCRETE FOUND IRON PIPE - I"

FOUND IRON PIPE -2"

FOUND SOLID IRON STAKE - 3/4" FOUND BRASS CAPPED MONUMENT FOUND CONCRETE MONUMENT

FENCE RECORDED AS

EXISTING GROUND ELEVATION

SCALE - I" = 30'

men WISCONSIN REGISTERED LAND SURVEYOR

10/27/83

83309 JOB NUMBER