


WALWORTH COUNTY
SURVEYING & MAPPING
LAKE GENEVA, WISCONSIN

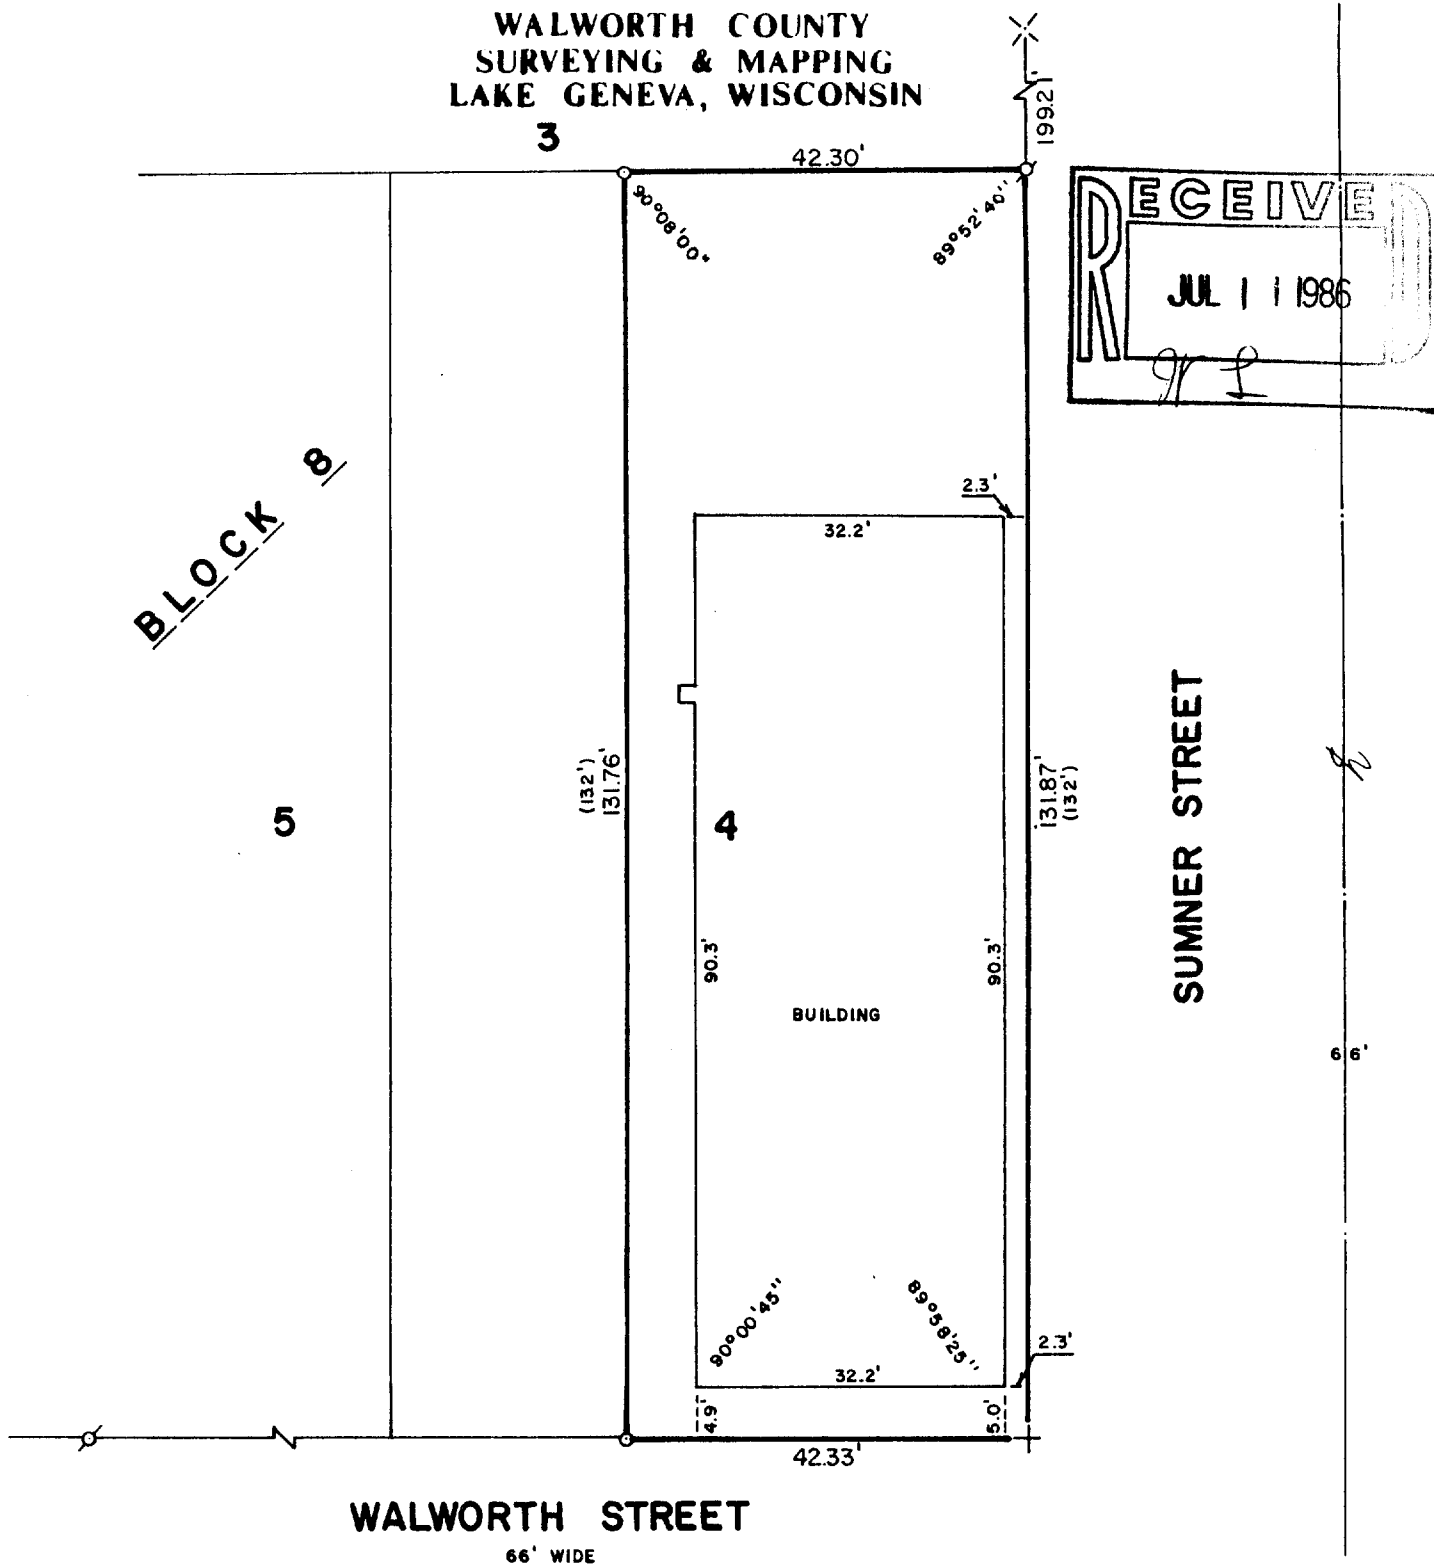

BLOCK 8

5

4

SUMNER STREET



WALWORTH STREET
66' WIDE

PLAT OF SURVEY OF

THE EAST 42 FEET OF LOT 4, BLOCK 8 OF FREEMANS 2nd ADDITION TO THE VILLAGE OF GENOA CITY, WALWORTH COUNTY, WISCONSIN.

ORDERED BY: DIANE BROBST
P. O. BOX 374
RICHMOND ILLINOIS 60071

NOTE: THIS IS A RETRACEMENT OF A PLAT OF SURVEY BY LLOYD JENSEN DATED APRIL, 1954.

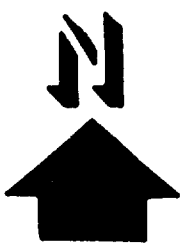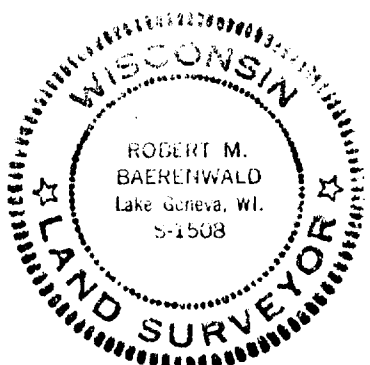

SCALE: 1"=20'

- o - IRON PIPE FOUND
- x - SPIKE FOUND
- o - IRON ROD PLACED
- + - CUT CROSS IN CONCRETE
- () - RECORDED AS

I, ROBERT M. BAERENWALD, DO HEREBY CERTIFY THAT I HAVE SURVEYED THE PROPERTY HEREON DESCRIBED ACCORDING TO THE OFFICIAL RECORDS AND THAT THE PLAT HEREON IS A CORRECT REPRESENTATION OF THE PROPERTY LINES TO THE BEST OF MY KNOWLEDGE AND BELIEF.

Robert M. Baerenwald
ROBERT M. BAERENWALD
WISCONSIN REGISTERED LAND SURVEYOR, S-1508

DATE *July 3, 1986* JOB NO. 0578

6-188