

PLAT OF SURVEY  
OF

LOT 1 OF CERTIFIED SURVEY NO. 21 FOR LAND LOCATED IN THE NORTHEAST 1/4 OF SECTION 35, T. 1 N., R. 18 E. VILLAGE OF GENOA CITY, COUNTY OF WAINWORTH, STATE OF WISCONSIN.




FOR: KUNZ.

SCALE 1" = 30'

o = 1-1/4" IRON PIPE STAKE FOUND

HEARING DATUM IS THAT OF CHM NO. 21

--- denotes fence line.

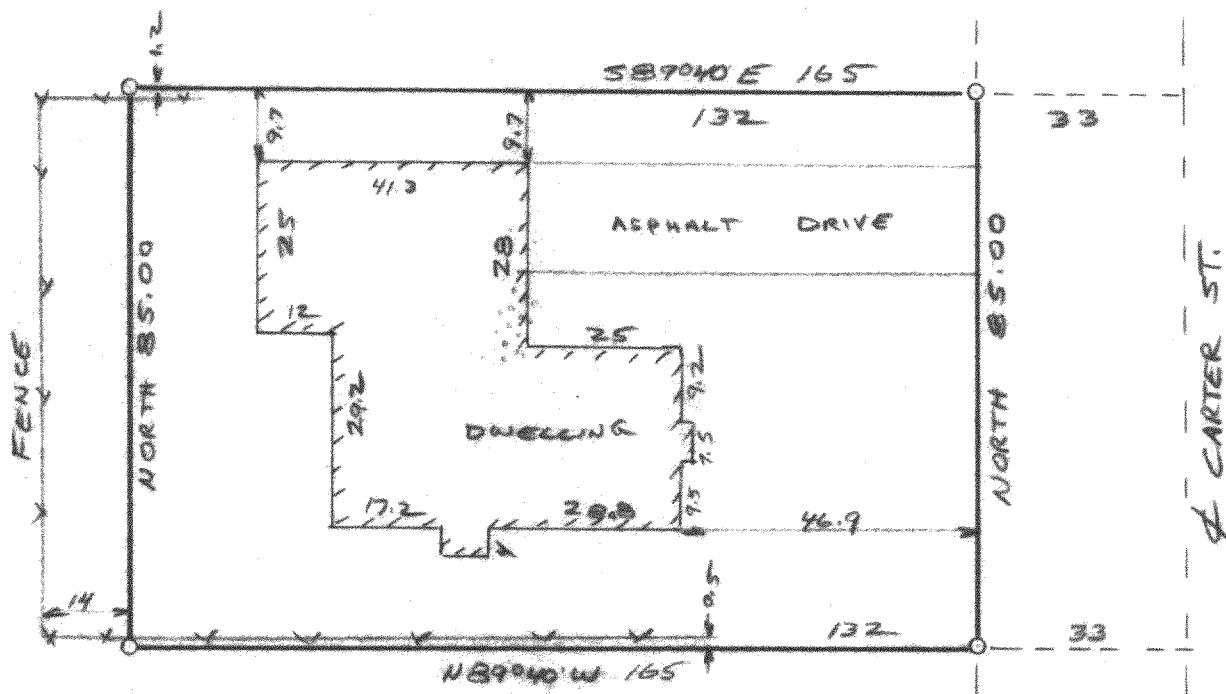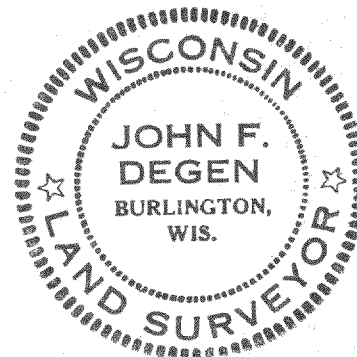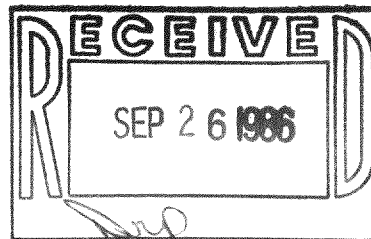

I have surveyed the above-described property, and the map hereon is a true representation thereof and shows the size and location of the property, its exterior boundaries, the location and dimensions of all visible structures thereon, fences, apparent easements and roadways and visible encroachments, if any.

This survey is made for the exclusive use of the present owners of the property, and also those who purchase, mortgage, or guarantee the title thereto, within one year from date hereof.

Dated at Burlington, this 18th day of AUGUST, 1986

*John F. Degen*  
John F. Degen, Land Surveyor S 242

11-0-1 #12

TA21-1

6-192