



PLAT OF SURVEY
OF

LOT 7, FREEMAN ADDITION TO THE VILLAGE OF GENOA CITY, LOCATED IN VILLAGE OF GENOA CITY, WALWORTH COUNTY, WISCONSIN.

FOR: TOM AND LINDA CHILDERS.

SCALE 1" = 30'

o = IRON PIPE STAKE FOUND.

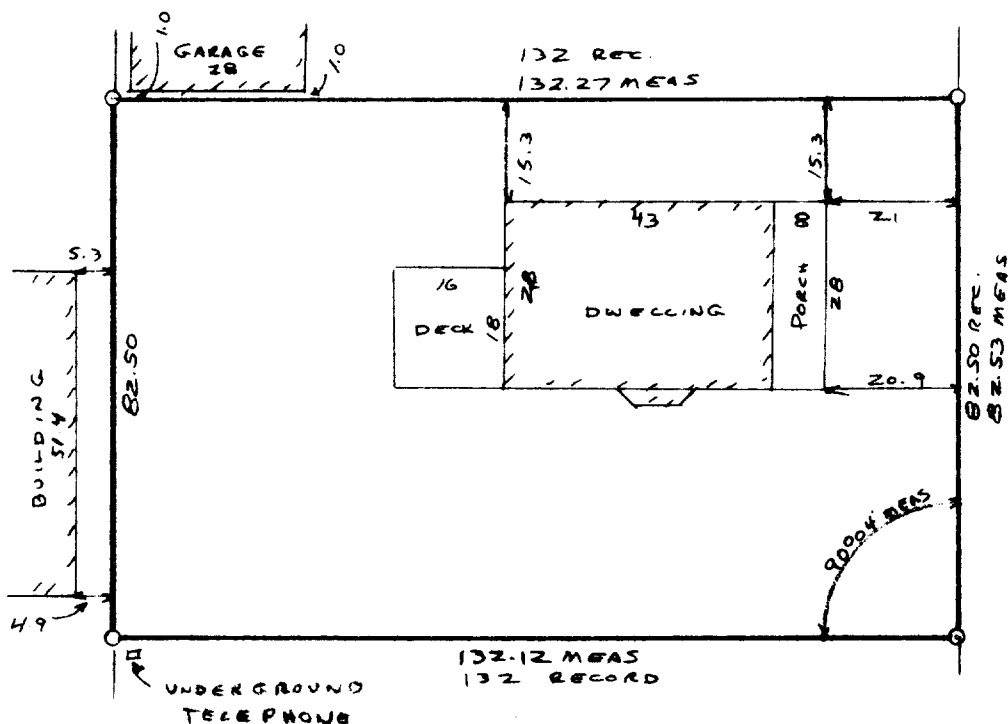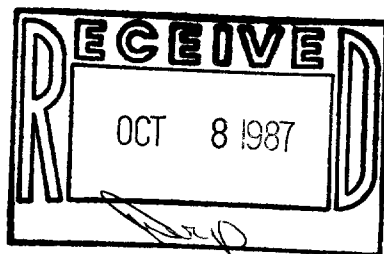

2 FREEMAN ST.

I have surveyed the above-described property, and the map hereon is a true representation thereof and shows the size and location of the property, its exterior boundaries, the location and dimensions of all visible structures thereon fences, apparent easements and roadways and visible encroachments, if any.

This survey is made for the exclusive use of the present owners of the property, and also those who purchase, mortgage, or guarantee the title thereto, within one year from date hereof.

Dated at Burlington, this 24th day of AUGUST, 1987

John F. Degen
John F. Degen, Land Surveyor S 242