


KOLB LAND CONSULTING, INC.
LAND SURVEYING • SUBDIVIDING • LAND PLANNING


LAKE GENEVA, WISCONSIN 53147

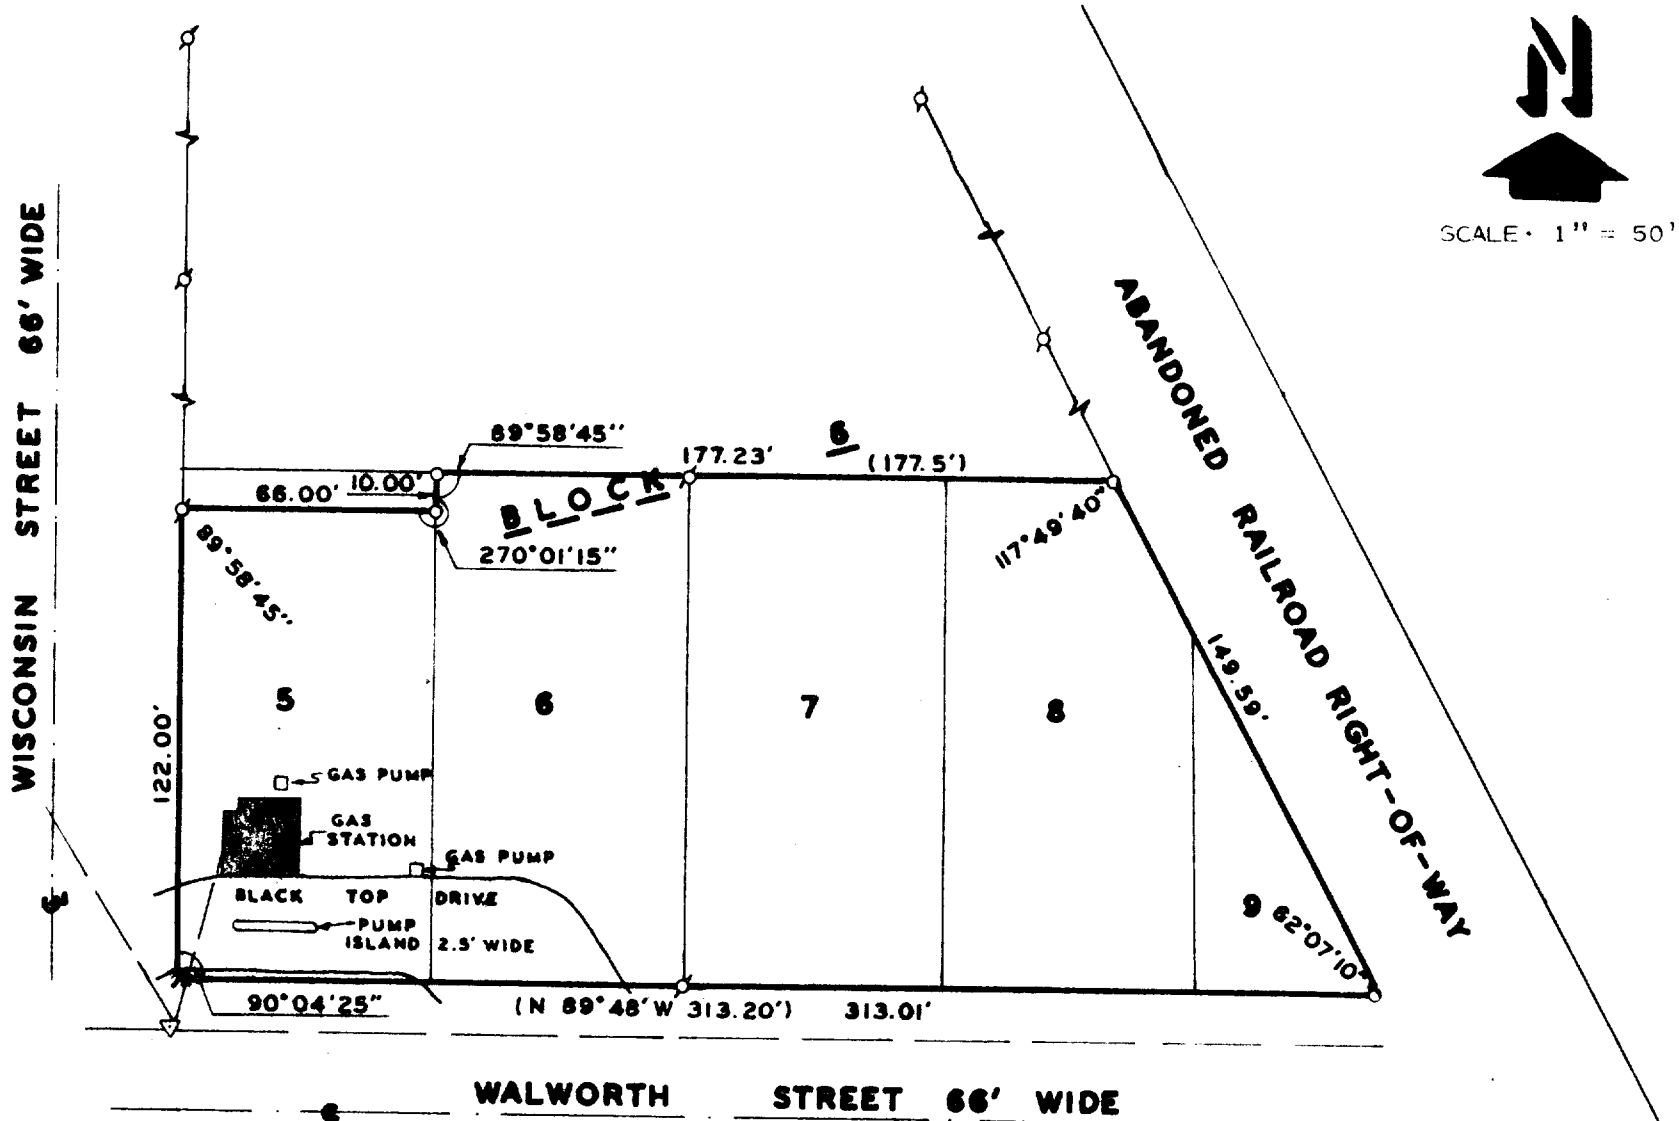

ORDERED BY: BILL ROBINSON
430 WALWORTH ST.
GENOA CITY, WI. 53128

LEGEND

- ⊕ - IRON PIPE FOUND
- X - IRON STRAP FOUND
- - 1" X 24" IRON PIPE SET
- Δ - UTILITY POLE
- - OVERHEAD UTILITY LINE
- () - AS RECORDED

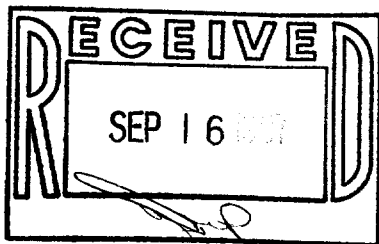

PLAT OF SURVEY OF

THE SOUTH 122.00 FEET OF LOT 5 AND ALL OF LOTS 6-9, ALL IN BLOCK 6, OF FREEMAN'S
2ND ADDITION, VILLAGE OF GENOA CITY, WALWORTH COUNTY, WISCONSIN.

I HEREBY CERTIFY THAT I HAVE SURVEYED THE ABOVE DESCRIBED PROPERTY AND THAT THE ABOVE MAP IS A TRUE REPRESENTATION THEREOF AND SHOWS THE SIZE AND LOCATION OF THE PROPERTY, ITS EXTERIOR BOUNDARIES, THE LOCATION OF ALL VISIBLE STRUCTURES AND DIMENSIONS OF ALL PRINCIPAL BUILDINGS THEREON, BOUNDARY FENCES, APPARENT EASEMENTS, ROADWAYS AND VISIBLE ENCROACHMENTS, IF ANY, TO THE BEST OF MY KNOWLEDGE AND BELIEF.

THIS SURVEY IS MADE FOR THE USE OF THE PRESENT OWNERS OF THE PROPERTY AND ALSO THOSE WHO PURCHASE, MORTGAGE, OR GUARANTEE THE TITLE THERETO WITHIN ONE (1) YEAR FROM DATE HEREOF.

Harold H. Kolb
HAROLD H. KOLB

WISCONSIN REGISTERED LAND SURVEYOR, S-137

DATE OCTOBER 23, 1986