
PLAT OF SURVEY

of the South 41.25 feet and the South 30 feet to the North 41.5 feet of Lot 12 ORIGINAL PLAT TO THE VILLAGE OF GENOA CITY, Walworth County, Wisconsin.

> AMBIT LAND SURVEYING P.O. Box 42 Bassett, WI. 53101 414-537-4874

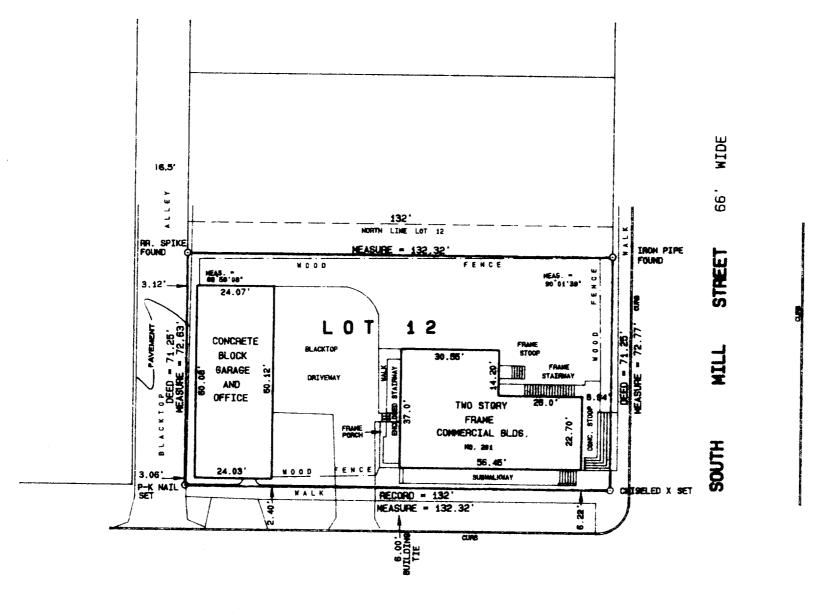

MAIN

STREET

WIDE

roadways and visible encrochments, if any.

thereto within one year from the date hereof.



SCALE ___!" = 30' CENTURY 21 ORDERED BY D. Anderson / Larry Hodges Realty JOB NO. 91228

аний принципантина в 19 година и 19 годин

La Ba Mark A. Bolender Wisconsin Registered Land Surveyor S - 1784

I hereby certify that I have surveyed the above described property and the above plat is a true representation thereof and shows the size and location of the property, its exterior boundaries, the location and dimensions of all visible structures thereon, boundary fences, apparent easements and

This survey is made for the exclusive use of the present owners of the property, and also those who purchase, mortgage, or guarantee the title

Dated at Bessett, Wisconsin this 8th day of November 1991.