

PLAT OF SURVEY
OF

LOT 11, OF MILLER'S ADDITION TO GENOA JUNCTION, LOCATED IN THE NORTH HALF OF SECTION 35, T. 1 N., R. 18 E. OF THE 4TH P.M., VILLAGE OF GENOA CITY, WALWORTH COUNTY, WISCONSIN.

FOR: KAROW SCALE 1" = 30' ρ = IRON PIPE STAKE FOUND.



I have surveyed the above-described property, and the map hereon is a true representation thereof and shows the size and location of the property, its exterior boundaries, the location and dimensions of all visible structures thereon, fences, apparent easements and readings and visible encroachments, if any.

This survey is made for the exclusive use of the present owners of the property, and also those who purchase, mortgage, or guarantee the title thereto, within one year from date hereof.

Dated at Burlington, this 16th day, of MARCH, 1992

John F. Degen

John F. Degen, Land Surveyor S 242
589 N. Pine St. Burlington, WI 53105

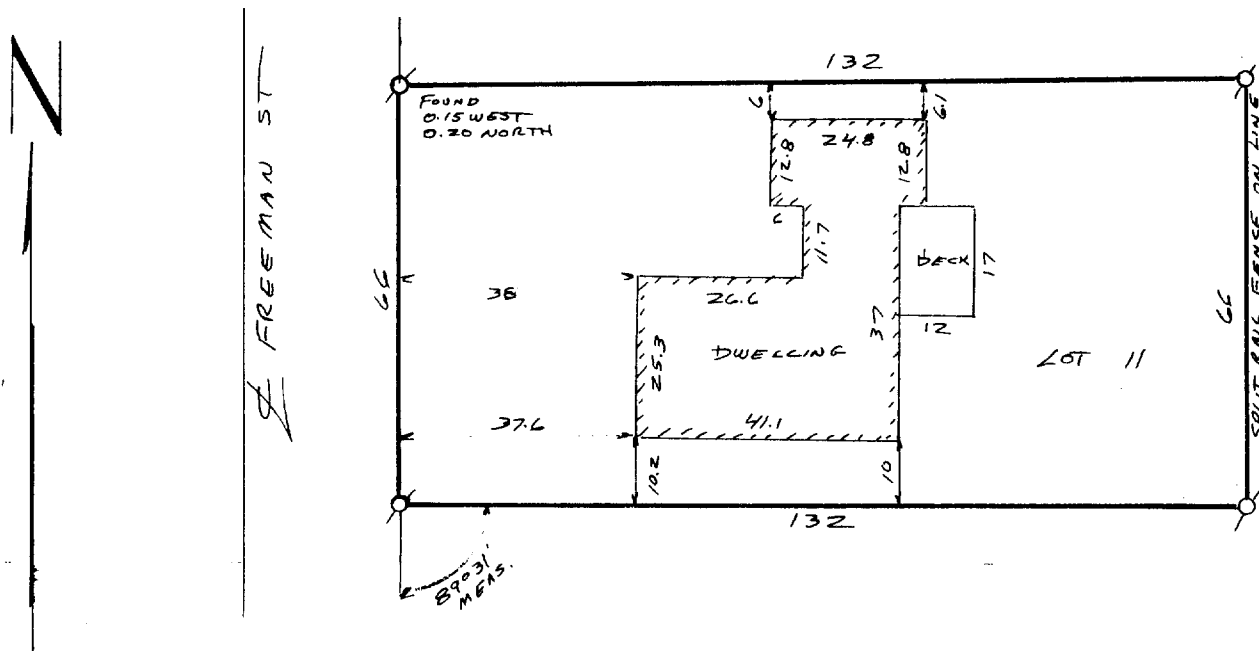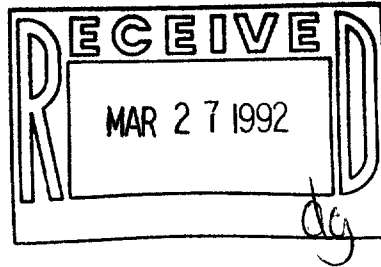

006-279

TMA-11 16-E-3 #30