

PART OF SECTION 35, T. 1 N., R. 18 E. OF THE 4TH P.M., VILLAGE OF GENOA CITY, COUNTY OF WALWORTH, STATE OF WISCONSIN AND MORE PARTICULARLY DESCRIBED AS FOLLOWS: COMMENCE 4 RODS WEST OF THE NORTHWESTCORNER OF LOT 1, BLOCK 1 OF STRAIN'S ADDITION, THENCE SOUTH 10 RODS; THENCE WEST 4 RODS; THENCE NORTH 10 RODS; THENCE EAST 4 RODS TO BEGINNING.



ST. ADDRESS: 517-519 WALWORTH ST.

FOR: JABLONOWSKI 1990 SCALE 1" = 30'
PURNELL 1992

⊘ = IRON PIPE STAKE FOUND

⌘ = IRON BOLT SET.

O = IRON PIPE SET 199Z

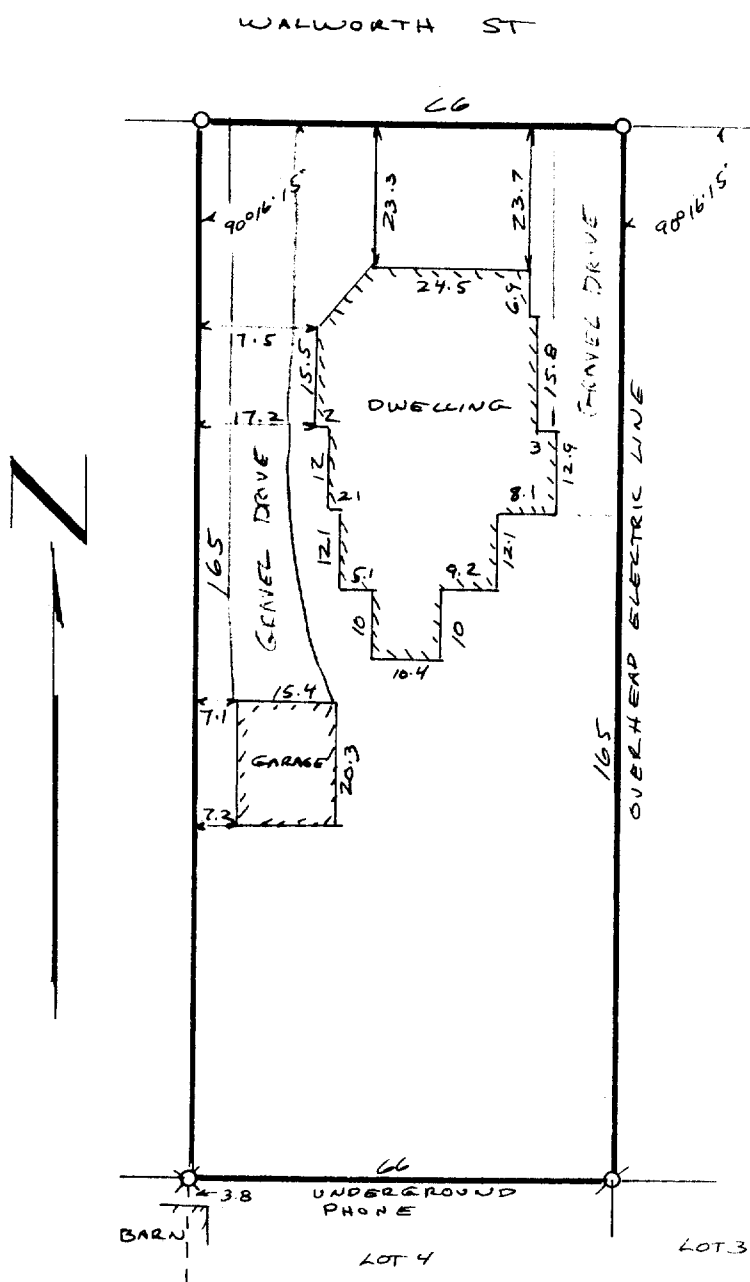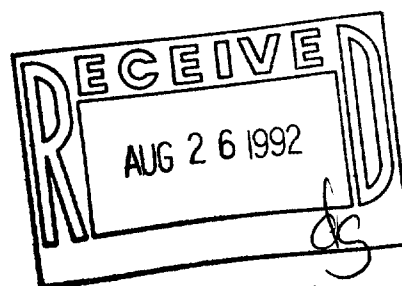

I have surveyed the above-described property, and as shown on the plan is a true section thereof and shows the size and location of the property, its exterior boundaries, the location and dimensions of all visible easements, fences, apparent easements and other rights and visible encroachments, if any.

This survey is made for the exclusive use of the present owners of the property, and also those who purchase, mortgage, or guarantee the title thereto, within one year from date hereof.

Dated at Burlington, this 30th day
of DECEMBER, 1990

John F. Degen
John F. Degen, Land Surveyor S 242
589 N. Pine St. Burlington, WI 53105
RE-SURVEYED 7-13-92.

006-283

TGC-73