


LAKE GENEVA, WISCONSIN 53147

LEGEND

- ORDERED BY: JOE MOOS
P.O. BOX 34
GENOA CITY, WI. 53128


EAST 11.59 FEET OF LOT 2, BLOCK 2
OF STRAINS ADDITION TO THE VILLAGE
OF GENOA CITY, WALWORTH COUNTY, WI.

NOTE: THIS IS A LOT LINE ADJUSTMENT.

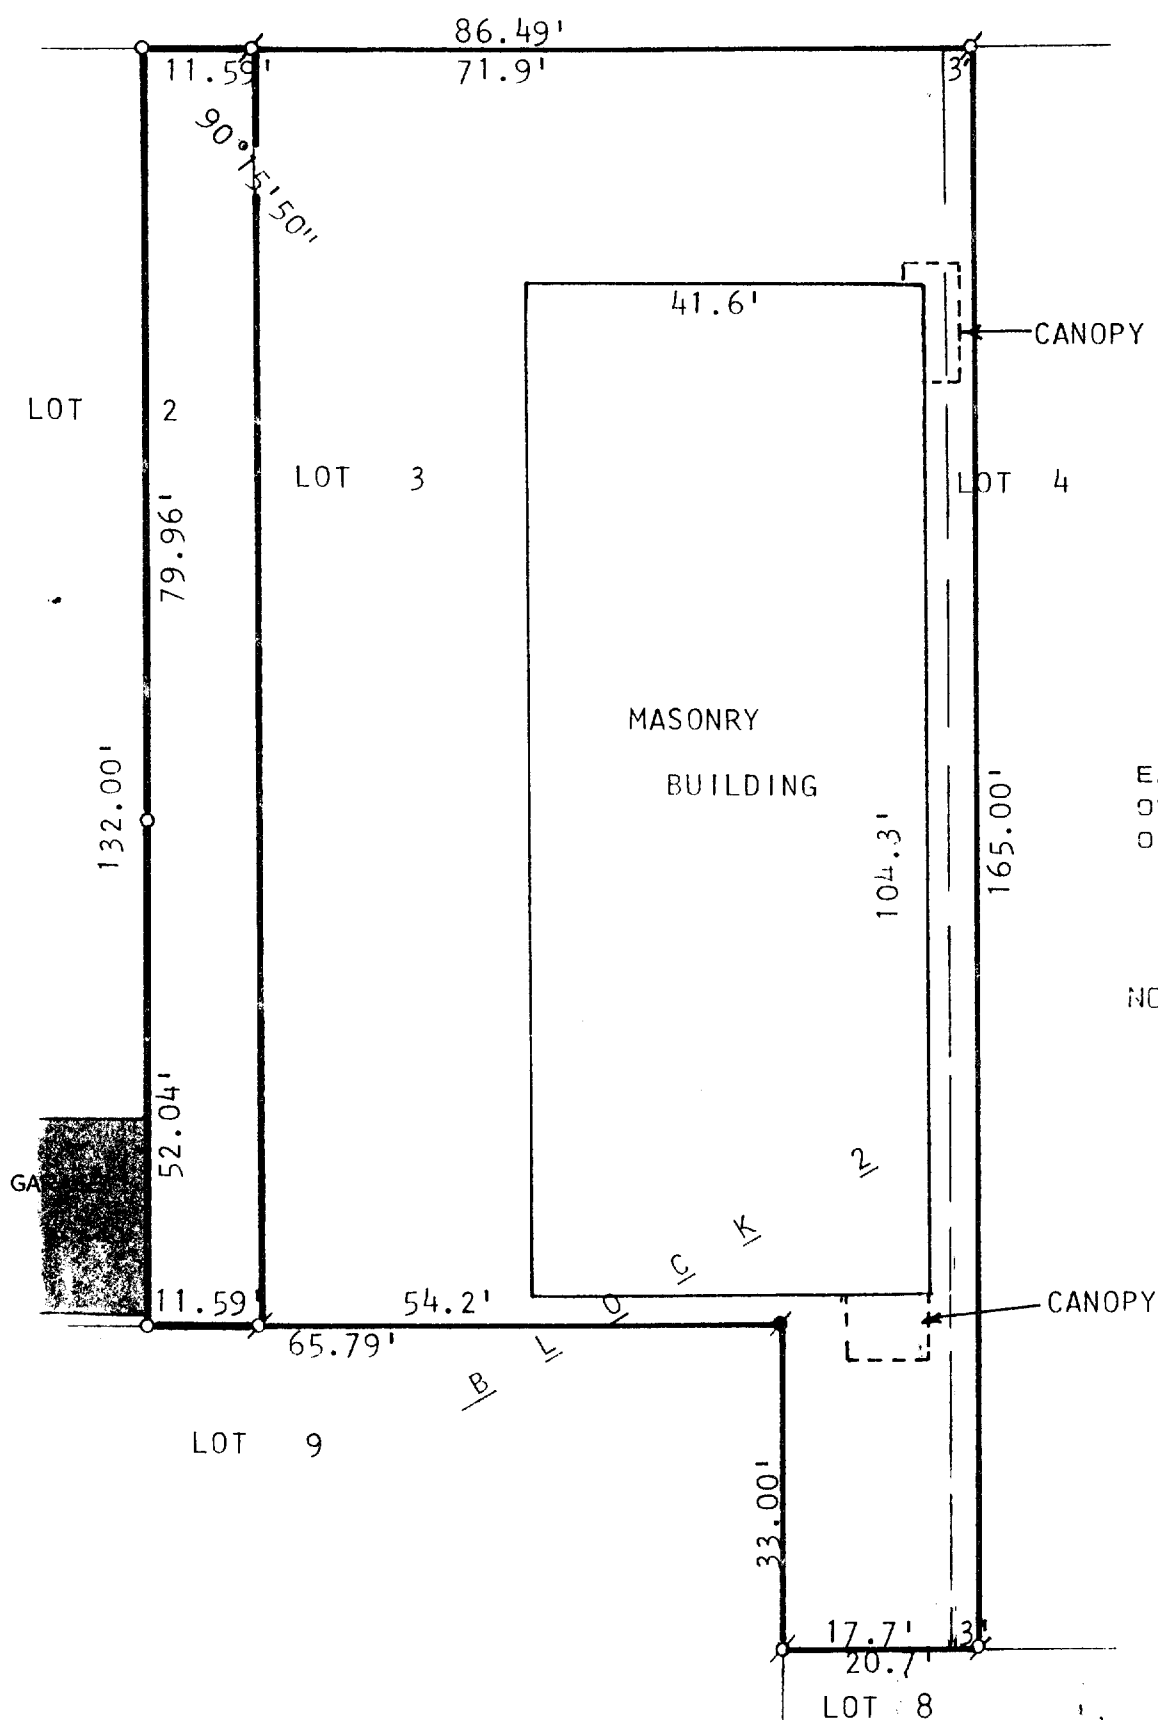

I, HAROLD H. KOLB, DO HEREBY CERTIFY
THAT I HAVE SURVEYED THE PROPERTY
HEREON DESCRIBED ACCORDING TO THE
OFFICIAL RECORDS, AND THAT THE PLAT
HEREON IS A CORRECT REPRESENTATION
OF THE LOT LINES AND THE PRINCIPAL
LINES OF THE BUILDINGS THEREON TO THE
BEST OF MY KNOWLEDGE AND BELIEF.
NOTE: SURVEY IS NOT VALID UNLESS THE
SURVEYOR'S SIGNATURE IS IN RED.

HAROLD H. KOLB
WISCONSIN REGISTERED LAND SURVEYOR, S- 187
DATE FEB. 1, 1991

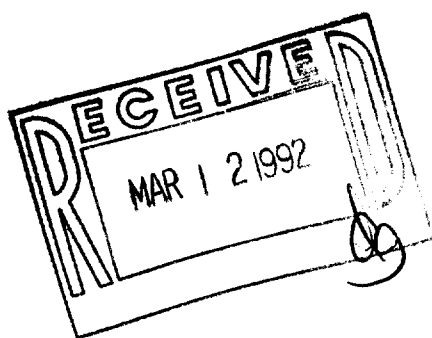

ØØ 6-284

GC-TVCB-75