

PLAT OF SURVEY
OF


LOT 1, OF WALWORTH COUNTY CERTIFIED SURVEY MAP NO. 2200 FOR LANDS LOCATED IN THE NORTHWEST 1/4
OF THE NORTHEAST 1/4 OF SECTION 35, T. 1 N., R. 18 E. OF THE 4TH P.M., VILLAGE OF GENOA CITY,
WALWORTH COUNTY, WISCONSIN.

FOR: ANDRESEN

SCALE 1" = 20'

⚡ = IRON PIPE STAKE FOUND.

BEARING DATUM IS THAT OF
RECORDED CSM.

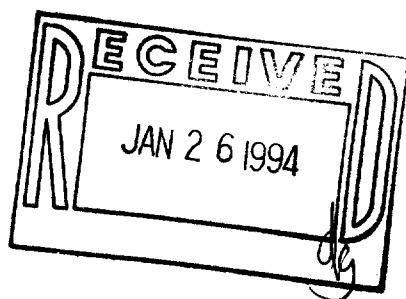

I have surveyed the above-described property,
and the map hereon is a true representation
thereof and shows the size and location of the
property, its exterior boundaries, the location
and dimensions of all visible structures thereon,
fences, apparent easements and roadways and
visible encroachments, if any.

This survey is made for the exclusive use of
the present owners of the property, and also
those who purchase, mortgage, or guarantee
the title thereto, within one year from date
hereof.

Dated at Burlington, this 21ST day,
of JANUARY, 1994

John F. Degen
John F. Degen, Land Surveyor S 242
589 N. Pine St. Burlington, WI 53105

