


KOLB LAND CONSULTING, INC.  
LAND SURVEYING • SUBDIVIDING • LAND PLANNING

LAKE GENEVA, WISCONSIN 53147

414-248-3697


NOTE: BEARINGS ARE ASSUMED AS SHOWN  
ON RECORDED CSM # 2233.

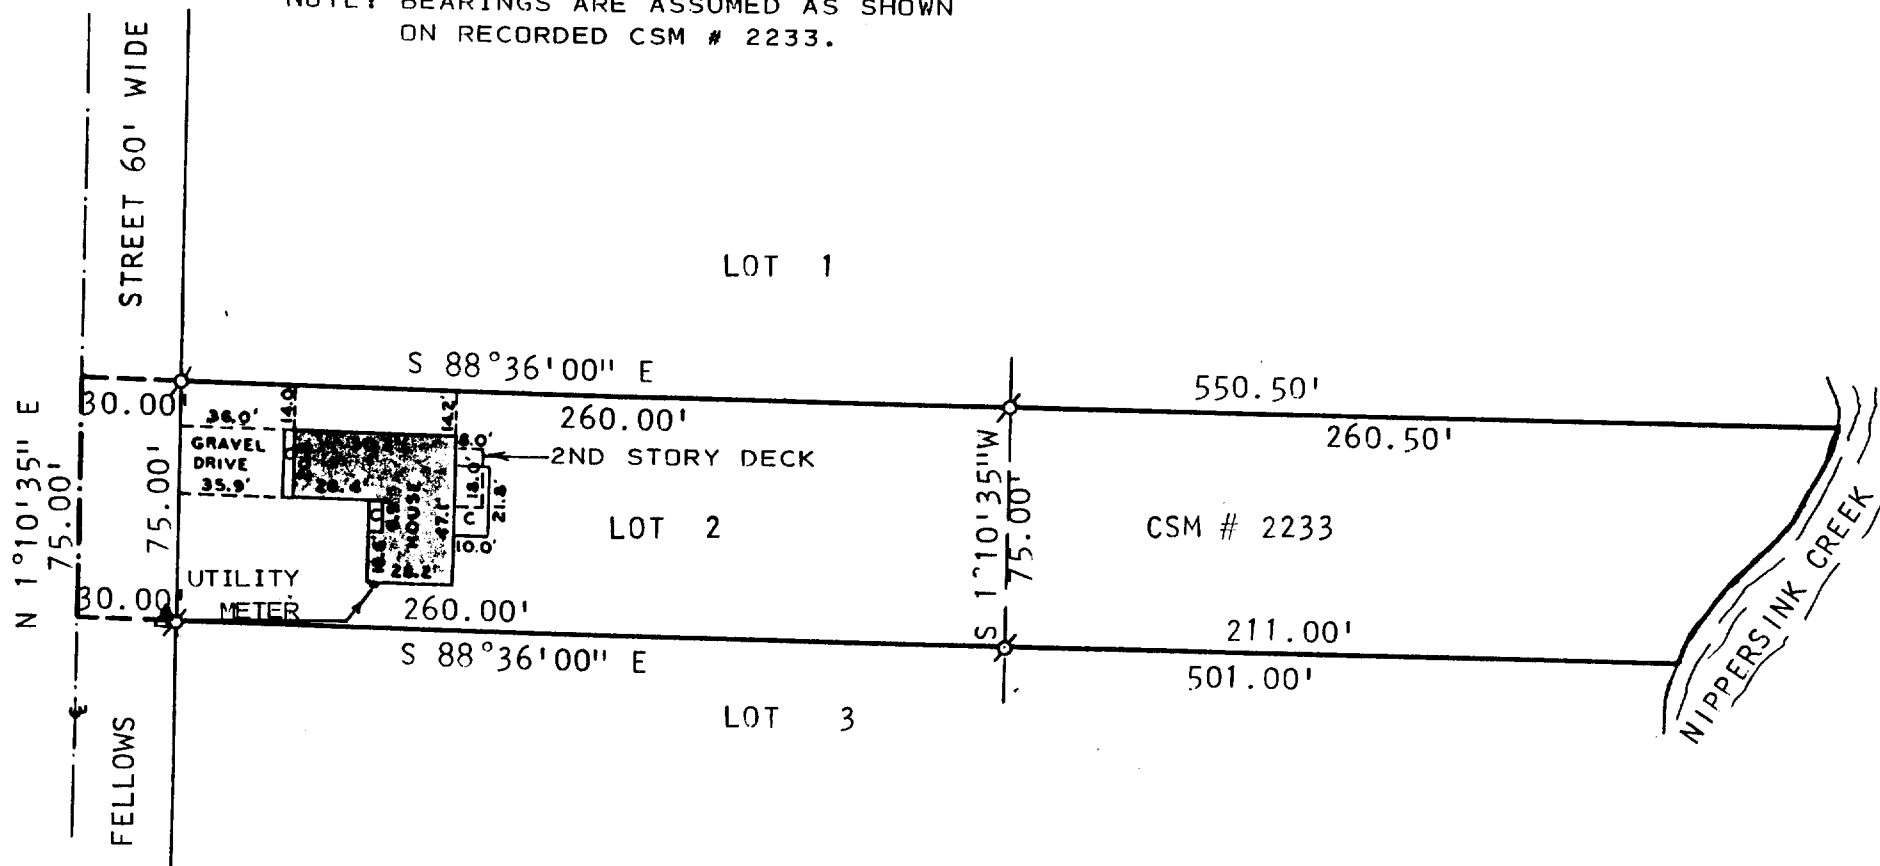

ORDERED BY: RICHARD HILLER  
3903 N. SPRING GROVE  
MCHENRY, IL. 60050

PLAT OF SURVEY OF

LOT 2 OF CERTIFIED SURVEY MAP NO. 2233,  
LOCATED IN THE SOUTHEAST 1/4 OF SECTION  
35, T1N, R18E, VILLAGE OF GENOA CITY,  
WALWORTH COUNTY, WISCONSIN.

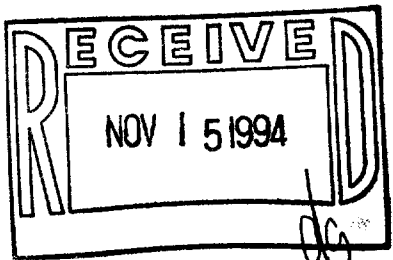

SCALE: 1" = 60'

LEGEND

- Ø - IRON PIPE FOUND
- C - CONCRETE
- Δ - UTILITY PEDESTAL
- ▲ - CABLE PEDESTAL

I HEREBY CERTIFY THAT I HAVE SURVEYED THE  
ABOVE DESCRIBED PROPERTY AND THAT THE ABOVE  
MAP IS A TRUE REPRESENTATION THEREOF AND  
SHOWS THE SIZE AND LOCATION OF THE PROPERTY  
ITS EXTERIOR BOUNDARIES, THE LOCATION OF ALL  
VISIBLE STRUCTURES AND DIMENSIONS OF ALL  
PRINCIPAL BUILDINGS THEREON, BOUNDARY FENCES,  
APPARENT EASEMENTS, ROADWAYS AND VISIBLE  
ENCROACHMENTS, IF ANY, TO THE BEST OF MY  
KNOWLEDGE AND BELIEF.

THIS SURVEY IS MADE FOR THE USE OF THE  
PRESENT OWNERS OF THE PROPERTY AND ALSO  
THOSE WHO PURCHASE, MORTGAGE OR GUARANTEE  
THE TITLE THERETO WITHIN ONE (1) YEAR FROM  
DATE HEREOF.  
SURVEY NOT VALID UNLESS SURVEYOR'S SIGNATURE  
IS IN RED.

HAROLD H. KOLB  
WISCONSIN REGISTERED LAND SURVEYOR, S-187  
DATE JANUARY 14, 1994