

FARRIS, HANSEN & ASSOCIATES, INC.  
ENGINEERING, ARCHITECTURE, SURVEYING  
7 RIDGWAY COURT - P.O. BOX 437, ELKHORN, WISCONSIN 53121  
PHONE: (414) 723-2098 FAX: (414) 723-5886


# PLAT OF SURVEY

LOTS 15 & 16 OF


GENOA TRAILS SUBDIVISION ADDITION NO. 1

A DIVISION OF LOT 3 OF CERTIFIED SURVEY MAP NO. 2191,  
RECORDED IN VOLUME NO. 10 ON PAGE NO. 277 OF WALWORTH COUNTY  
CERTIFIED SURVEY MAPS AS DOCUMENT NO. 239621 LOCATED IN  
THE NW 1/4 OF THE SW 1/4 OF SECTION 36, TOWN 1 NORTH, RANGE  
18 EAST; VILLAGE OF GENOA CITY, WALWORTH COUNTY, WISCONSIN

## STERLING COURT

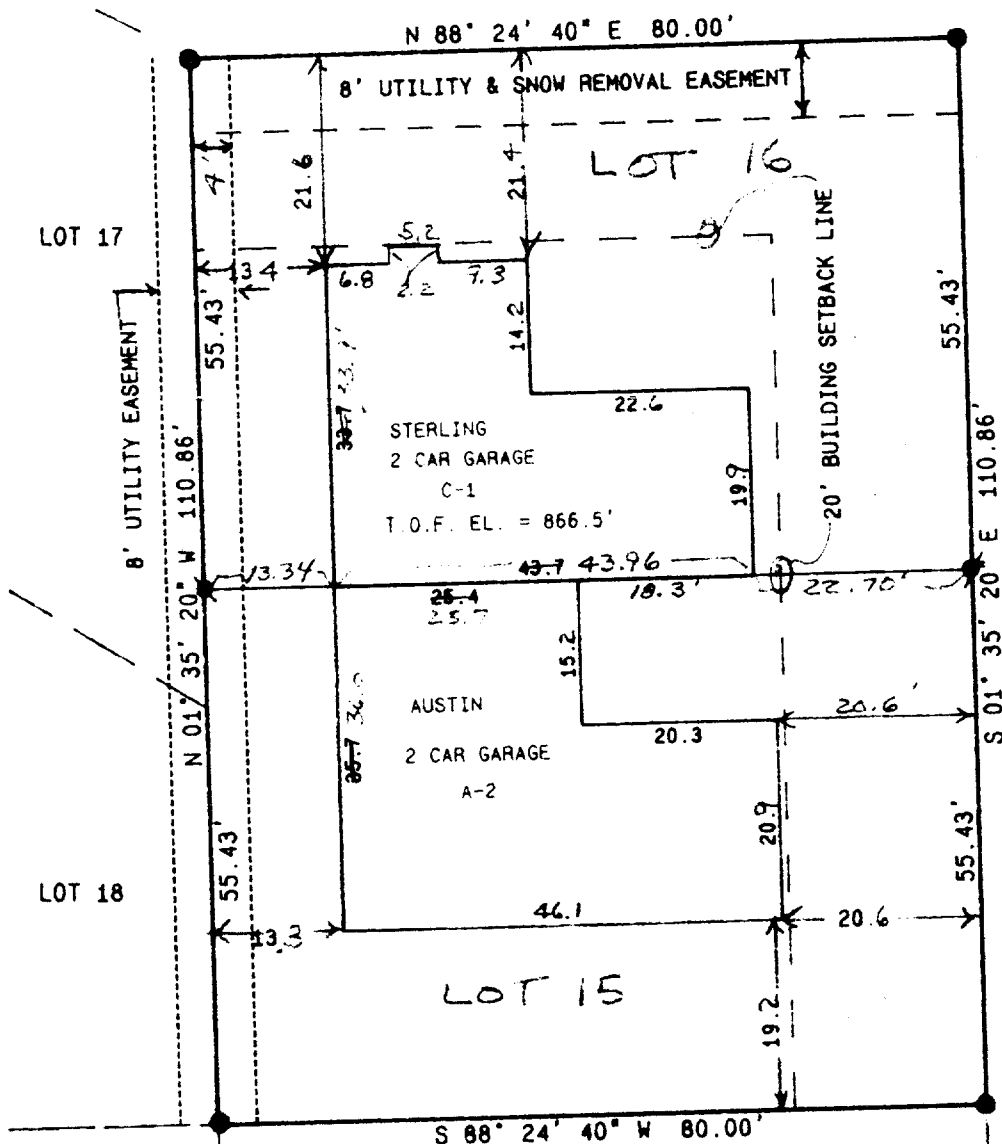


FENMORE LANE

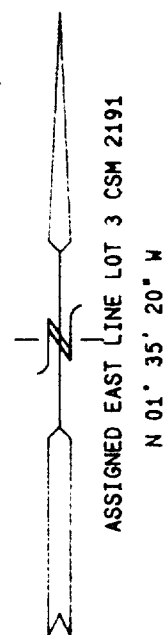


OWNER AND DEVELOPER:  
JOHN C. TRACY & ASSOCIATES, AN ILLINOIS  
CORPORATION  
509 W. OLD N.W. HIGHWAY  
BARRINGTON, ILLINOIS 60010

LOT 14  
GENOA TRAILS SUBDIVISION

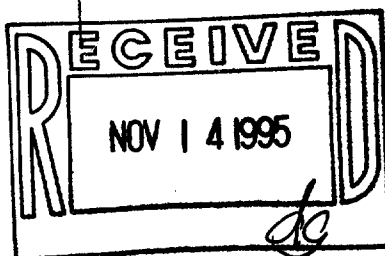

- = FOUND IRON REBAR STAKE
- = SET IRON REBAR STAKE
- = SET WOOD HUB STAKE
- = FOUND IRON PIPE STAKE

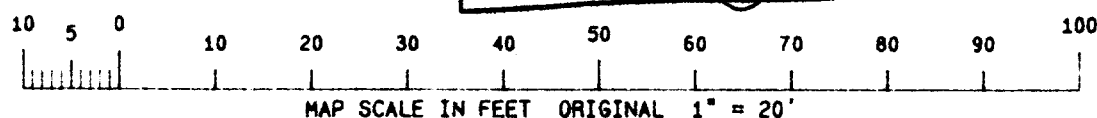


NOTE: COPIES OF THIS MAP TO WHICH THE FOLLOWING CERTIFICATE WILL APPLY ARE BLUE LINE PRINTS SHOWING SURVEYOR'S ORIGINAL SEAL AND SIGNATURE IN BLACK INK. COPIES BY ANY OTHER MEANS MAY HAVE ALTERATIONS WHICH DO NOT REPRESENT THE SURVEYOR'S WORK PRODUCT.

I HEREBY CERTIFY THAT THE ABOVE DESCRIBED PROPERTY HAS BEEN SURVEYED UNDER MY DIRECTION AND THAT THE ABOVE MAP IS A TRUE REPRESENTATION THEREOF AND SHOWS THE SIZE AND LOCATION OF THE PROPERTY AND ITS EXTERIOR BOUNDARIES. THIS SURVEY IS MADE FOR THE USE OF THE PRESENT OWNERS OF THE PROPERTY, AND ALSO THOSE WHO PURCHASE, MORTGAGE, OR GUARANTEE THE TITLE THERETO WITHIN ONE YEAR FROM THE DATE HEREOF.

DATED: 6/30/95

REVISED 10/17/95 TO SHOW AS-BUILT SIZE AND LOCATION

*Peter S. Gordon*  
PETER S. GORDON R.L.S. 2101

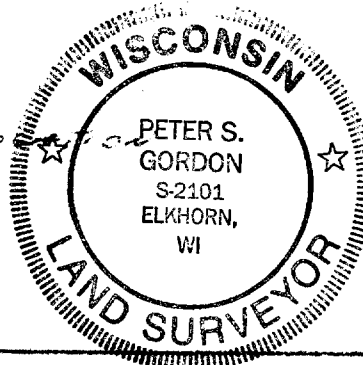

PROJ 3828  
SHEET 1 OF 1

006-370