
0 F

A parcel of land located in the Village of Genoa City, in the Southeast Guarter of Section 35, Town i North, Range 18 East of the 4th Principal Meridian, Walworth County, Wisconsin, described as follows, to-wit: Commencing at the southeast corner of Zarnstorff's Addition, according to a plat thereof on record in the office of the Register of Deeds in and for Walworth County, Wisconsin; thence South 205 feet to the place of beginning; thence continuing South 180 feet to a pipe; thence West 95 feet to a pipe; thence North 180 feet to a pipe; thence East to the place of beginning, all in the Village of Genoa City, Walworth County, Wisconsin.



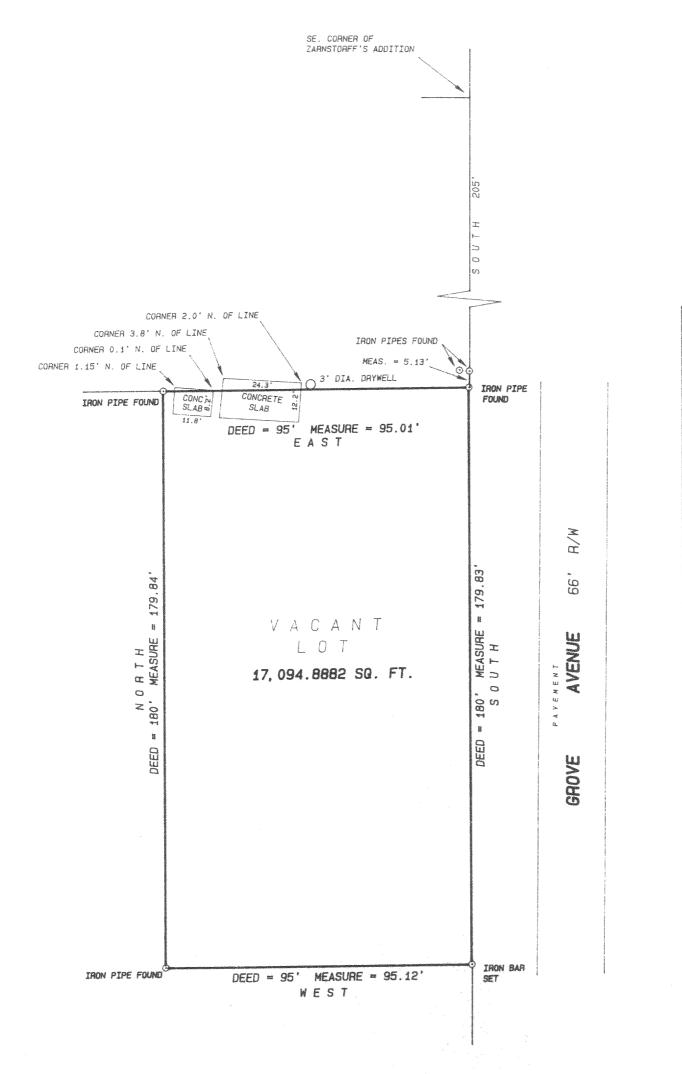

SCALE | inch = 30 feet

ORDERED BY A. Prejng/REMAX Plaza

JOB NO. 96087

I hereby certify that I have surveyed the above described property and the above plat is a true representation thereof and shows the size and location of the property, its exterior boundaries, the location and dimensions of all visible extructures thereon, boundary fences, apparent easements and roadways and visible encrochments, if any.

This survey is made for the exclusive use of the present owners of the property, and also those who purchase, mortgage, or guarantee the title thereto within one year from the date hereof.

Attack to the				
Dated	at Bassett, Wisconsi	n this day	0.6	1996.
Maria M	or messere arecoust	1 633 2 0 453 3	wr.	and the property of the contract of the contra

Mark A. Bolender Wisconsin Registered Land Surveyor S - 1784