

982005
982005S1.DWG

PLAT OF SURVEY

SURVEYED FOR: RALPH WELLS
WELLS-OSBORN SPIRAL STAIRS
162 WALWORTH STREET
GENOA CITY, WI 53128

[illegible]

SCALE 17 = 100


C. T. H. "H" WALWORTH STREET

(FORMERLY STATE HIGHWAY "12")

(100' WIDE)

LEGEND

- ② FOUND RUN 1 RE
 ● FOUND RUN 1
 1 RET 100% RBE
 ——— FENCE
 ② RECORDED AT
 ② — UTILITY POLE

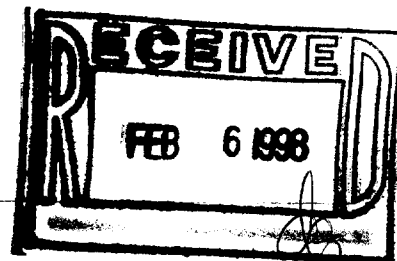

I HEREBY CERTIFY THAT I HAVE SURVEYED THE ABOVE DESCRIBED PROPERTY AND THE ABOVE MAP IS A TRUE REPRESENTATION THEREOF AND SHOWS THE SIZE AND LOCATION OF THE PROPERTY, THE LOCATION OF ALL VISIBLE STRUCTURES AND DIMENSIONS OF ALL PRINCIPAL BUILDINGS THEREON, BOUNDARY FENCES, APPARENT EASEMENTS, ROADWAY AND VISIBLE ENCROACHMENTS, IF ANY.

THIS SURVEY IS MADE FOR THE PRESENT OWNERS OF THE PROPERTY, AND ALSO THOSE WHO PURCHASE OR GUARANTEE THE TITLE THERETO WITHIN (1) YEAR FROM THE DATE HEREOF.

MAILED AT **WATERFORD** THIS **9TH** DAY OF **JANUARY** 1908

RECERTIFIED

TUCC-87A
006-513