


PLAT OF SURVEY

PATHFINDER SURVEYING
FORMERLY KOLB LAND CONSULTING
929 WILLIAMS STREET LAKE GENEVA, WI. 53147
(414) 248-3697


DATE: 10/23/1998

ORDERED BY: CENTURY 21 LARRY HODGES REALTY
143 MAIN ST. P.O. BOX 939
TWIN LAKES, WISCONSIN 53181

DESCRIPTION: LOT 4 AND THE NORTH 66 FEET OF THE SOUTHERLY
132 FEET OF LOT 11 OF MANOR'S ADDITION TO THE
VILLAGE OF GENOA CITY, A SUBDIVISION LOCATED IN
T1N, R18E, WALWORTH COUNTY, WISCONSIN.

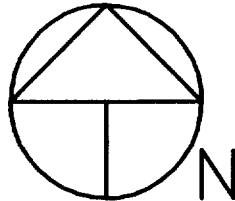

SCALE 1"=30'


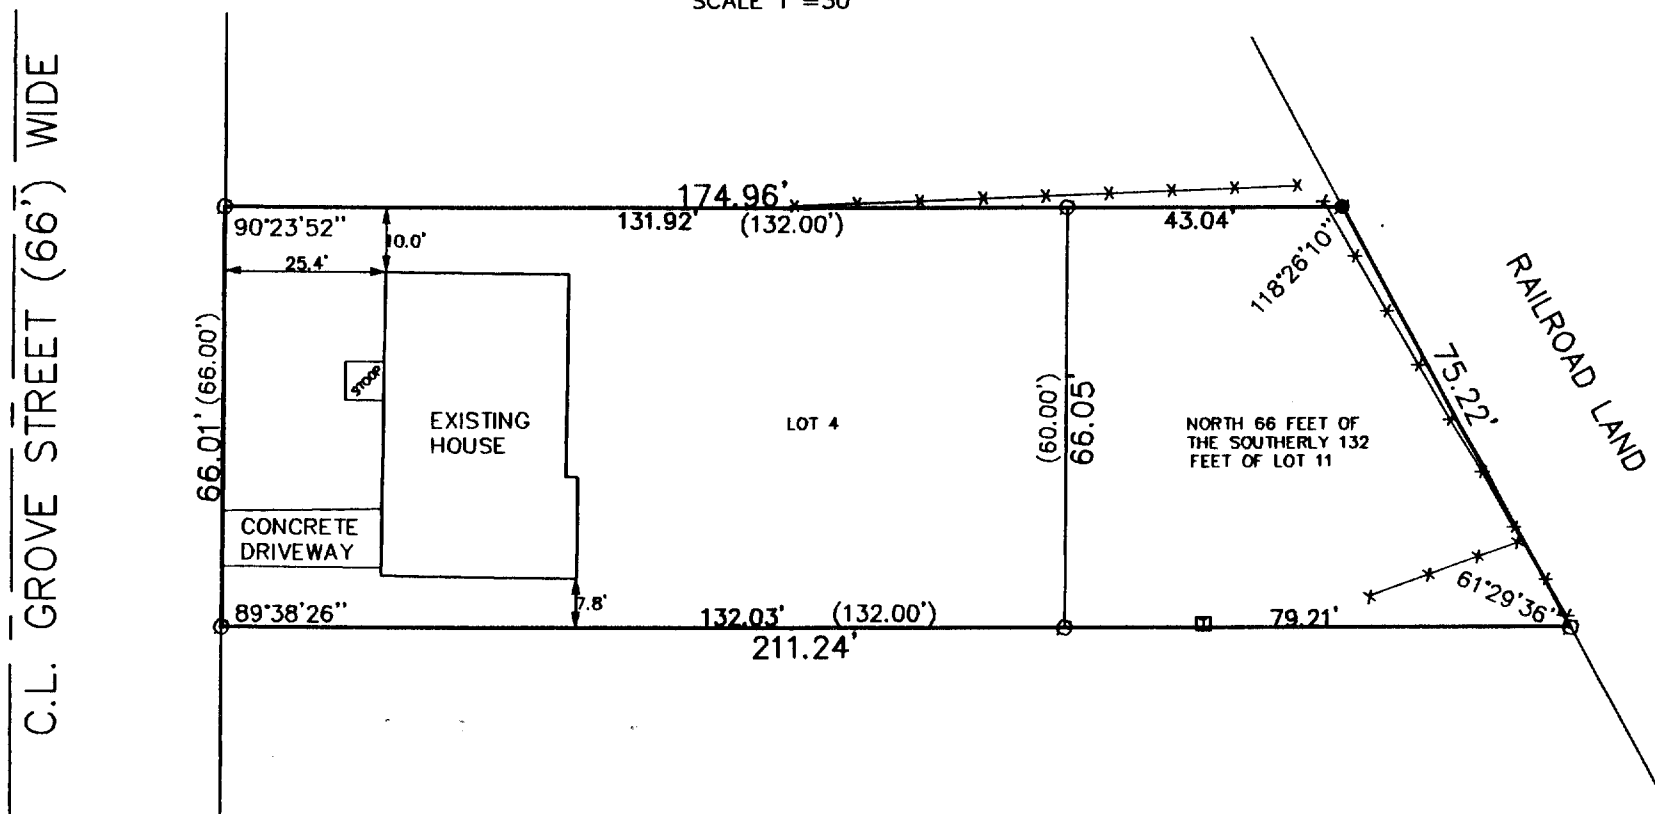


LEGEND

- SET IRON PIPE
- FOUND IRON PIPE
- ▣ TELEPHONE PEDASTAL
- (XXX) RECORDED AS
- *— FENCE

THE ABOVE MAP IS A TRUE REPRESENTATION THEREOF AND SHOWS THE SIZE AND LOCATION OF ALL THE PROPERTY, EXTERIOR BOUNDARIES, THE LOCATION OF ALL VISIBLE BOUNDARY FENCES, APPARENT EASEMENTS, ROADWAYS AND VISIBLE ENCROACHMENTS, IF ANY

THIS SURVEY IS MADE FOR THE USE OF THE PRESENT OWNERS OF THE PROPERTY, AND ALSO THOSE WHO PURCHASE, MORTGAGE OR GUARANTEE TITLE THERETO WITHIN ONE (1) YEAR FROM DATE HERETO.

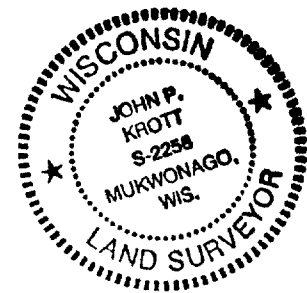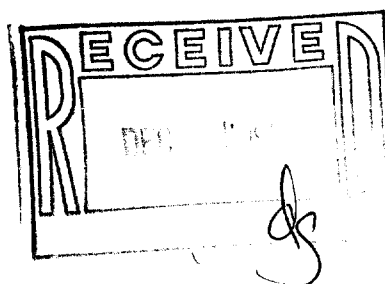

John P. Krott
JOHN P. KROTT, R.L.S. 2258

NOTE: THIS IS NOT A CERTIFIED COPY UNLESS SEAL IS IN RED.

JOB NUMBER #98209 TM00004

TM-4 006-568