
HAROLD H. KOLB

REGISTERED PROFESSIONAL LAND SURVEYOR

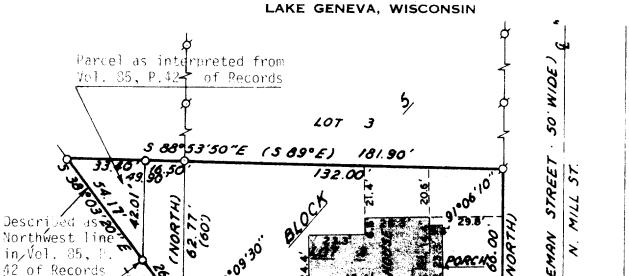

129.43' (127')

LOT

68°53'50"E

PLAT OF SURVEY OF

LOT 2, BLOCK 5, CIFFORD'S ADDITION AND A PARCEL OF LAND LOCATED IN THE NORTHEAST 1/4 OF SECTION 35, T1N, R18E, VILLAGE OF SENDA CITY, WALMORTH COUNTY. WISCONSIN.

OWHER: CLARK W. HOLDEN

ACCURACY: DISTANCES: T F. 71' ANGLES: ERROR OF CLOSURE: LESS THAN ONE PART IN 3,000

SCALE: 1:40' LEGEND

- IRON PIPE FOUND

- IRON PIPE PLACED

- CONCRETE MONUMENT

X - SPIKE

- As Recorded

I. HAROLD H. KOLB, DO HEREBY CERTIFY THAT I HAVE SURVEYED THE PROPERTY HEREON DESCRIBED ACCORDING TO THE OFFICIAL RECORDS, AND THAT THE PLAT HEREON IS A CORRECT REPRESENTATION OF THE LOT LINES. AND BUILDING LINES THEPRON.

WISCONSIN REGISTERED LAND SURVEYOR, S-187
DATE March 11, 1976