


HAROLD H. KOLB
REGISTERED PROFESSIONAL LAND SURVEYOR
LAKE GENEVA, WISCONSIN

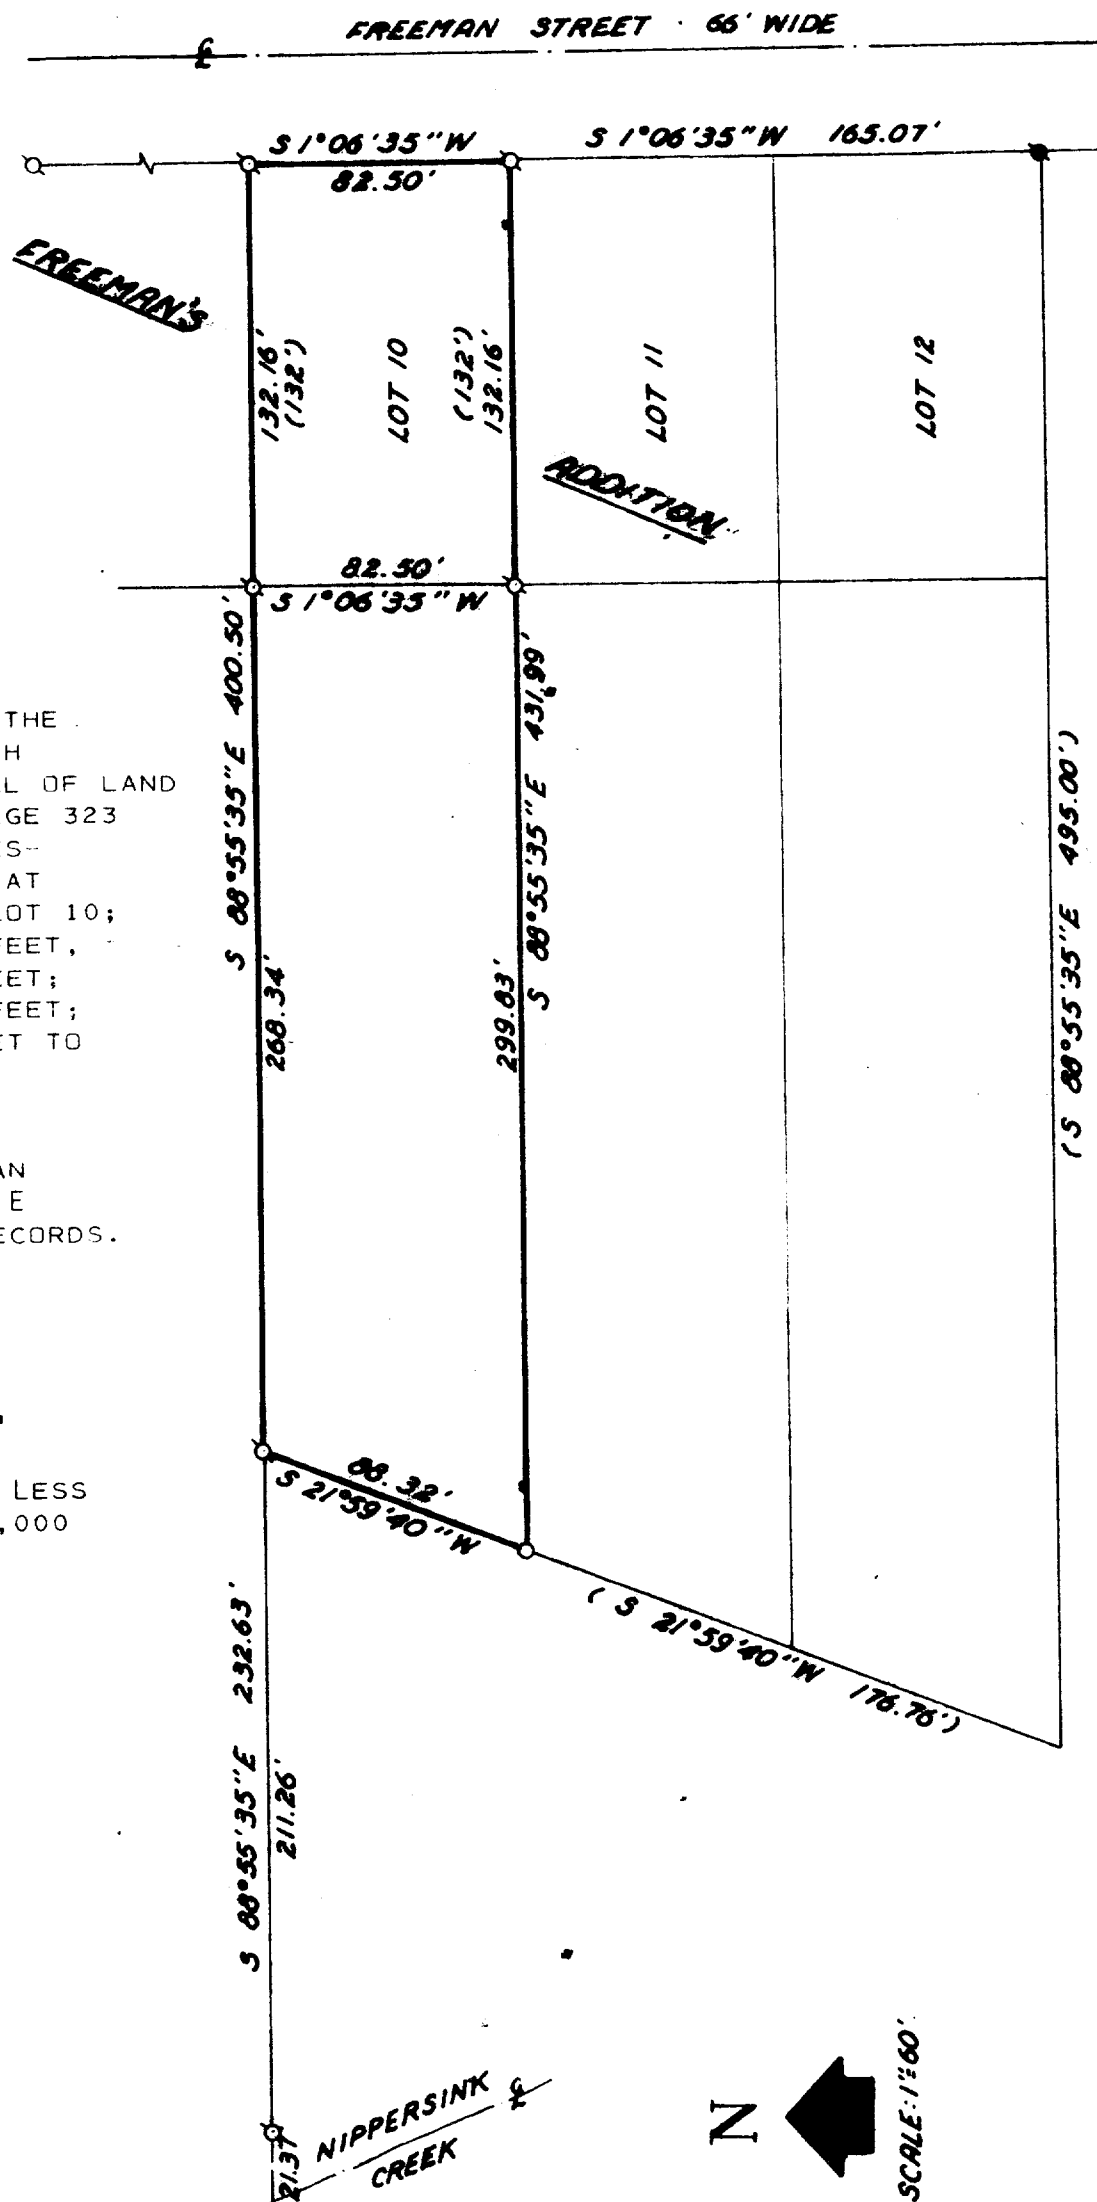


PLAT OF SURVEY OF

LOT 10, FREEMAN'S ADDITION TO THE VILLAGE OF GENOA CITY, WALWORTH COUNTY, WISCONSIN, AND A PARCEL OF LAND AS DESCRIBED IN VOLUME 436, PAGE 323 OF DEEDS, MORE PARTICULARLY DESCRIBED AS FOLLOWS: BEGINNING AT THE NORTHWEST CORNER OF SAID LOT 10; THENCE N 88°55'35" W 268.34 FEET; THENCE S 21°59'40" W 88.32 FEET; THENCE S 88°55'35" E 299.83 FEET; THENCE N 1°06'35" E 82.50 FEET TO THE PLACE OF BEGINNING.

NOTE: THE WEST LINE OF FREEMAN STREET IS ASSUMED N 1°06'35" E AS SHOWN ON EXISTING SURVEY RECORDS.

ORDERED BY: WILLIAM ROWDEN

ACCURACY; DISTANCES: $\pm 0.01'$
ANGLES: $\pm 05''$
ERROR OF CLOSURE: LESS THAN ONE PART IN 3,000

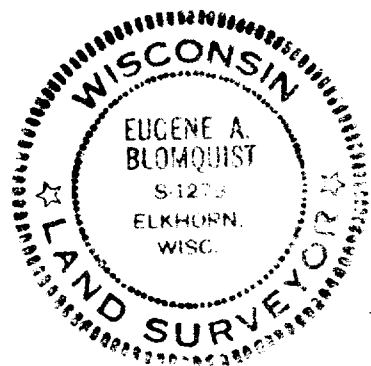

LEGEND

- φ - IRON PIPE FOUND
- - IRON PIPE PLACED
- - CONCRETE MONUMENT
- x - SPIKE
- () - RECORDED AS

I, Eugene Blomquist, DO HEREBY CERTIFY THAT I HAVE SURVEYED THE PROPERTY HEREON DESCRIBED ACCORDING TO THE OFFICIAL RECORDS, AND THAT THE PLAT HEREON IS A CORRECT REPRESENTATION OF THE LOT LINES.

EUGENE A. BLOMQUIST
WISCONSIN REGISTERED LAND SURVEYOR, S-1279
DATE

TFR-10

6-61