FARRIS, HANSEN & ASSOCIATES, INC.


ENGINEERING, ARCHITECTURE, SURVEYING 7 RIDGEWAY COURT - P.O. BOX 437, ELKHORN, WISCONSIN, 53121

> (414) 723-2098 FAX: (414) 723-5886 PHONE:

PLAT OF SURVEY

LOT 40 OF HUNTERS RIDGE SUBDIVISION

LOCATED IN ALL 1/4'S OF THE SW 1/4 SECTION 25, TOWN 1 NORTH, RANGE 18 EAST VILLAGE OF GENOA CITY, WALWORTH COUNTY, WISCONSIN

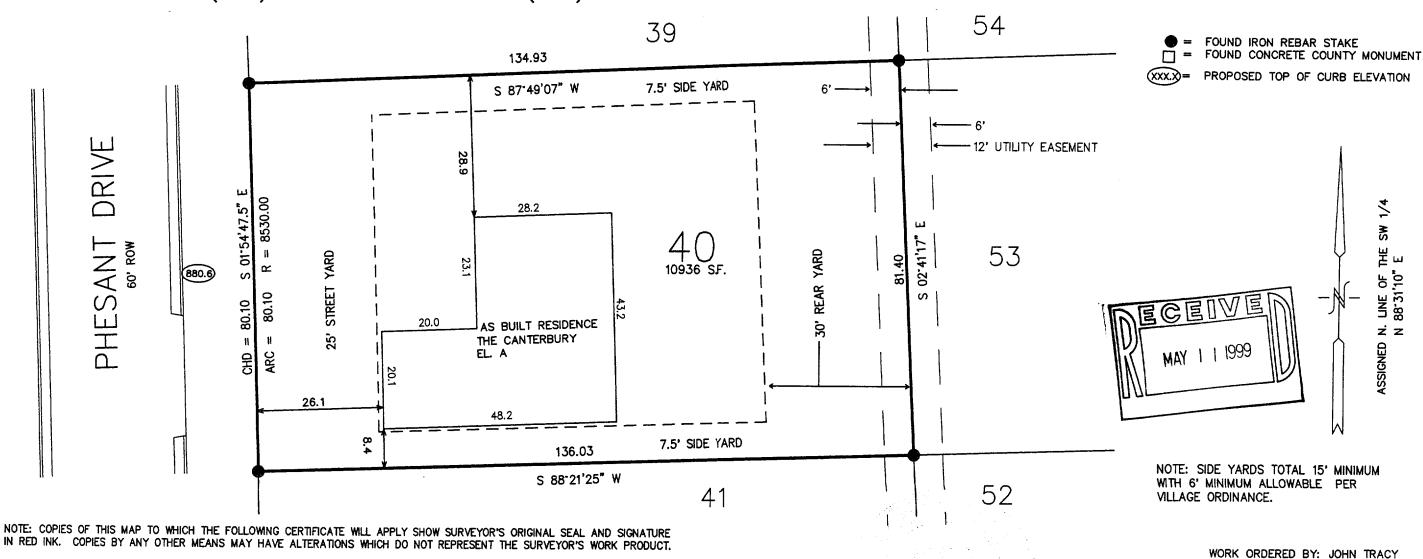

IN RED INK. COPIES BY ANY OTHER MEANS MAY HAVE ALTERATIONS WHICH DO NOT REPRESENT THE SURVEYOR'S WORK PRODUCT.

I HEREBY CERTIFY THAT THE ABOVE DESCRIBED PROPERTY HAS BEEN SURVEYED UNDER MY DIRECTION AND THAT THE ABOVE MAP IS A TRUE REPRESENTATION THEREOF AND SHOWS THE SIZE AND LOCATION OF THE PROPERTY, ITS EXTERIOR BOUNDARIES, THE LOCATION OF ALL VISIBLE STRUCTURES, AND DIMENSIONS OF ALL PRINCIPLE BUILDINGS THEREON, BOUNDARY FENCES, APPARENT EASEMENTS, ROADWAYS, AND VISIBLE ENCROACHMENTS, IF ANY. THIS SURVEY IS MADE FOR THE USE OF THE PRESENT OWNERS OF THE PROPERTY, AND ALSO THOSE WHO PURCHASE, MORTGAGE, OR GUARANTEE THE TITLE THERETO WITHIN ONE YEAR FROM THE DATE HEREOF.

> REVISED 03-21-99 TO SHOW SIZE & LOCATION OF RESIDENCE AS BUILT

PETER S. GORDON R.L.S. 2101

10 5 0 70 MAP SCALE IN FEET ORIGINAL 1" = 20'

DATED: 02-25-99

PROJECT 4267.40

SHEET 1 OF 1

THE TRACY GROUP

506 W. OLD N.W. HWY.

BARRINGTON, IL. 60010