
ENGINEERING, ARCHITECTURE, SURVEYING 7 RIDGEWAY COURT - P.O. BOX 437, ELKHORN, WISCONSIN, 53121

PLAT OF SURVEY

LOT 57 OF HUNTERS RIDGE SUBDIVISION

LOCATED IN ALL 1/4'S OF THE SW 1/4 SECTION 25, TOWN 1 NORTH, RANGE 18 EAST VILLAGE OF GENOA CITY, WALWORTH COUNTY, WISCONSIN

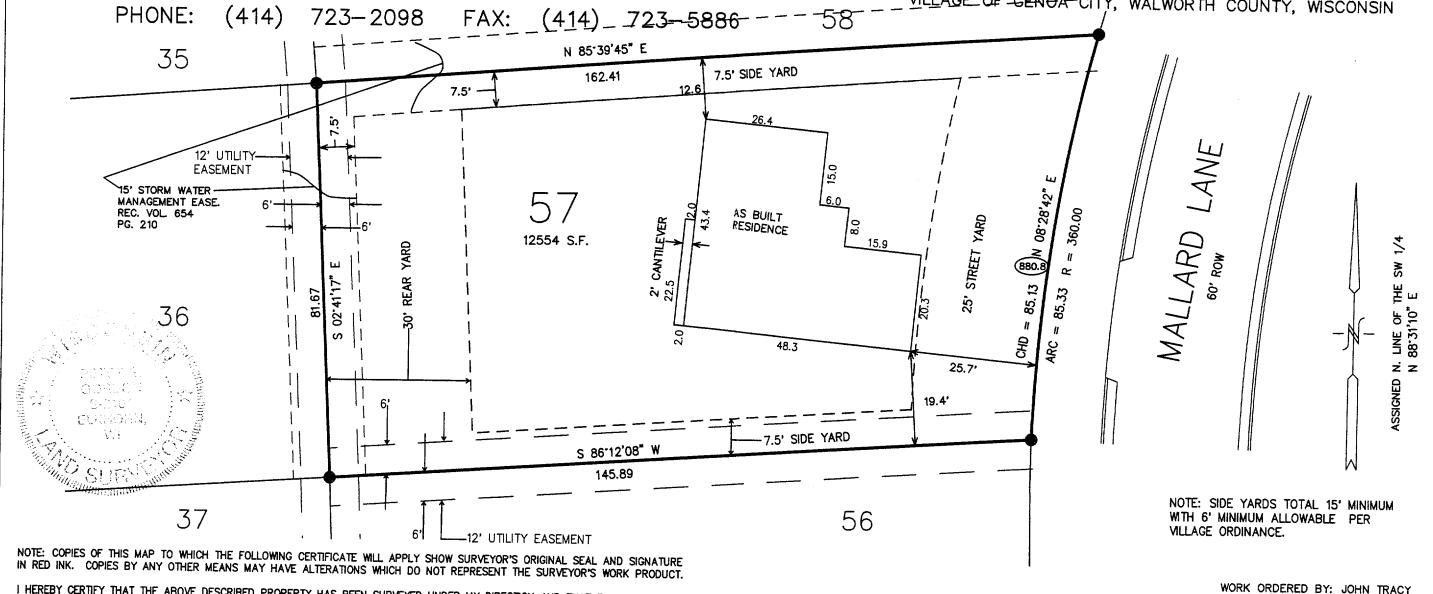


I HEREBY CERTIFY THAT THE ABOVE DESCRIBED PROPERTY HAS BEEN SURVEYED UNDER MY DIRECTION AND THAT THE ABOVE MAP IS A TRUE REPRESENTATION THEREOF AND SHOWS THE SIZE AND LOCATION OF THE PROPERTY, ITS EXTERIOR BOUNDARIES, THE LOCATION OF ALL VISIBLE STRUCTURES, AND DIMENSIONS OF ALL PRINCIPLE BUILDINGS THEREON, BOUNDARY FENCES, APPARENT EASEMENTS, ROADWAYS, AND VISIBLE ENCROACHMENTS, IF ANY. THIS SURVEY IS MADE FOR THE USE OF THE PRESENT OWNERS OF THE PROPERTY, AND ALSO THOSE WHO PURCHASE, MORTGAGE, OR GUARANTEE THE TITLE THERETO WITHIN ONE YEAR FROM

DATED: 04-12-99

PETER S. GORDON R.L.S. 2101

REVISED 06-07-99 TO SHOW SIZE & LOCATION OF RESIDENCE AS BUILT

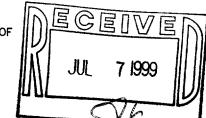

FOUND IRON REBAR STAKE FOUND CONCRETE COUNTY MONUMENT

PROPOSED TOP OF CURB ELEVATION

MAP SCALE IN FEET ORIGINAL

PROJECT 4267.57

SHEET 1 OF 1

THE TRACY GROUP

509 W. OLD N.W. HWY.

BARRINGTON, IL. 60010

THR-57