PATHFINDER SURVEYING

FORMERLY KOLB LAND CONSULTING 929 WILLIAMS STREET LAKE GENEVA, W. 53147 (414) 248-3697

ORDERED BY: CENTURY 21 ZENK REALTY LLC


112 ELIZABETH LN

GENOA CITY, WI 53128


DATE: 11-8-19899

DESCRIPTION:

THE NORTH 99.5 FEET OF THE FOLLOWING DESCRIBED PREMISES: BEGINNING AT THE S 1/4 CORNER OF SECTION 35, T1N, R18E OF THE 4TH P. M. TSP. OF BLOOMFIELD, COUNTY OF WALWORTH, STATE OF WISCONSIN, RUN THENCE NORTH ON THE NORTH AND SOUTH 1/4 SECTION LINE 500.00 FEET TO A POINT, SAID POINT MARKS THE PLACE OF OF BEGINNING OF THE PARCEL OF LAND HEREINAFTER DESCRIBED; RUN THENCE S 89'58' W 200.00 FEET TO A POINT; THENCE SOUTH 187.15 FEET TO A POINT; THENCE S 34'04' W 15.52 FEET TO A POINT, THENCE N 89'58' E 206.85 FEET TO A POINT, THENCE N 34'04' E 3.29 FEET TO A POINT, THENCE NORTH 197.26 FEET TO A POINT AND THE PLACE OF BEGINNING. SAID PARCEL OF LAND IS LOCATED IN THE SW 1/4 OF SECTION 35, TIN, R18E, VILLAGE OF GENOA CITY, COUNTY OF WALWORTH, STATE OF WISCONSIN.

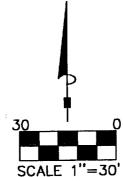


BEARINGS REFERENCED TO PREVIOUS SURVEY OF RECORD

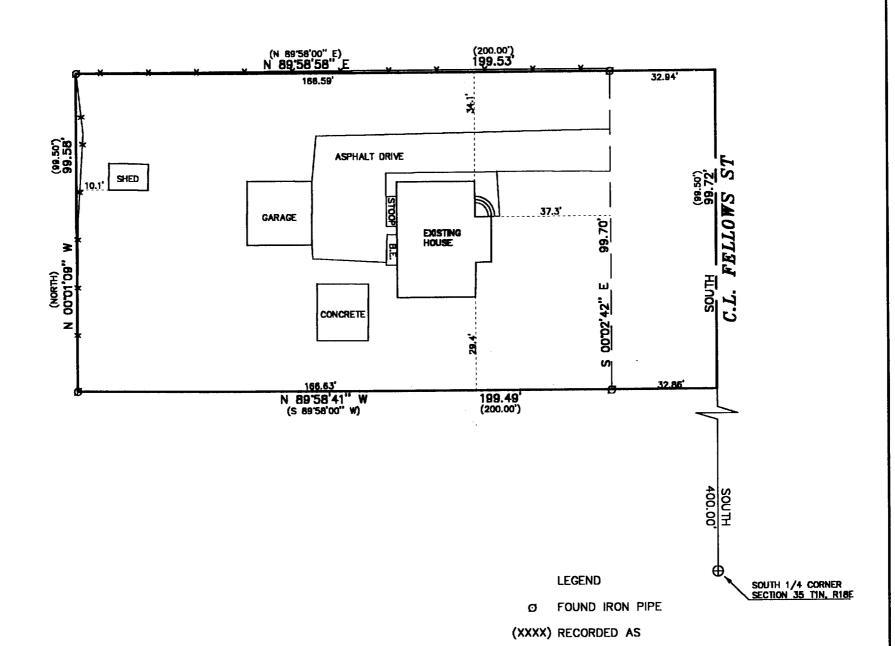


THE ABOVE MAP IS A TRUE REPRESENTATION THEREOF AND SHOWS THE SIZE AND LOCATION OF ALL THE PROPERTY, EXTERIOR BOUNDARIES, THE LOCATION OF ALL MSIBLE BOUNDARY FENCES, APPARENT EASEMENTS, ROADWAYS AND VISIBLE ENCROACHMENTS, IF ANY

THIS SURVEY IS MADE FOR THE USE OF THE PRESENT OWNERS OF THE PROPERTY, AND ALSO THOSE WHO PURCHASE, MORTGAGE OR GURANTEE TITLE THERETO WITHIN ONE (1) YEAR FROM DATE HERETO.

JOHN P. KROTT, R.L.S. 2258

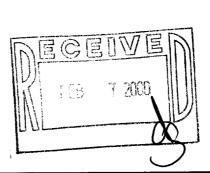

-X FENCE

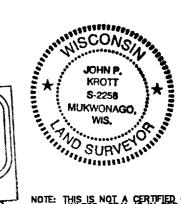

NOTE: THIS IS NOT A CERTIFIED COPY UNLESS SEAL IS IN RED.

JOB NUMBER #99268 TVGC 000 598