


DEGEN, FOAT SURVEYING ASSOCIATES


100 SOUTH SECOND STREET
WATERFORD, WISCONSIN
(414)534-5404 (FAX)534-2022

993241
993241S1.DWG

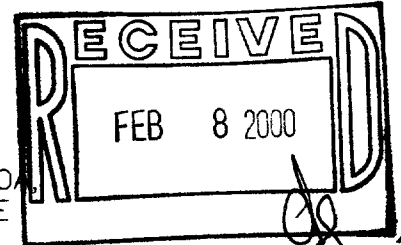

PLAT OF SURVEY

LOT 10, IN BLOCK 7 OF FREEMAN'S 2ND ADDITION TO THE VILLAGE OF GENOA, A SUBDIVISION LOCATED IN THE WEST PART OF THE NORTHEAST 1/4 OF THE SOUTHEAST 1/4 OF SECTION 35, TOWN 1 NORTH, RANGE 18 EAST OF THE FOURTH PRINCIPAL MERIDIAN, VILLAGE OF GENOA CITY, WALWORTH COUNTY, WISCONSIN.

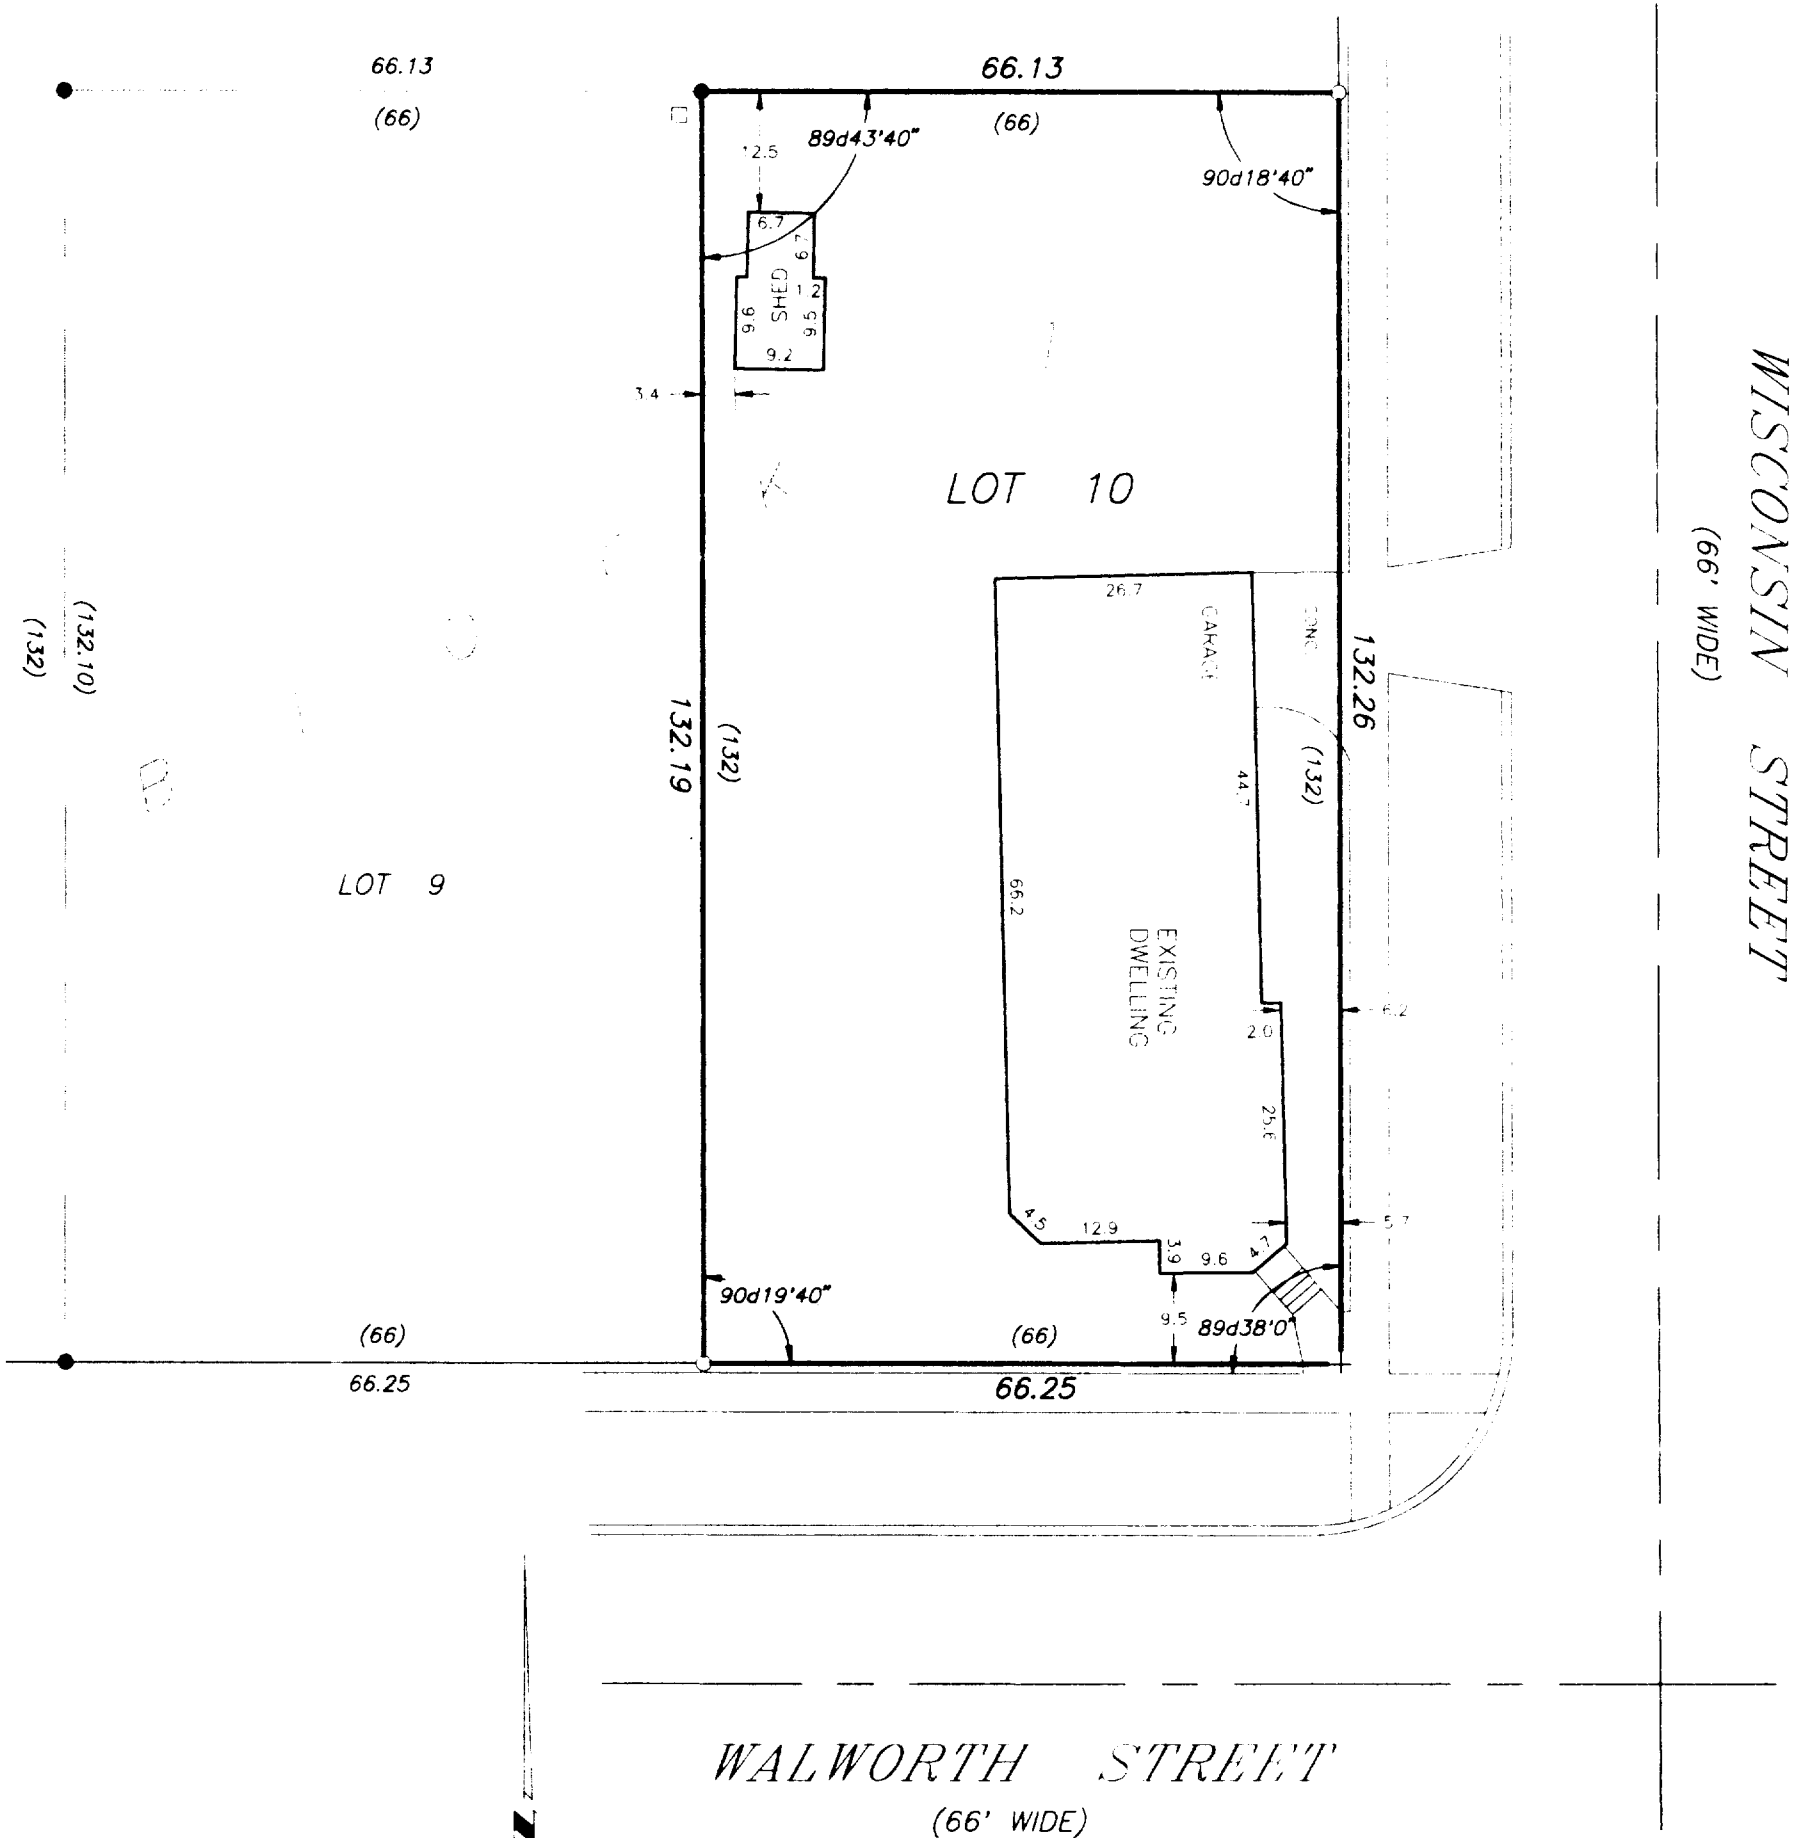

LEGEND

- + - CROSS CUT IN CONCRETE
- - FOUND IRON PIPE
- - SET IRON PIPE
- () - RECORDED AS
- - TELEPHONE PEDESTAL

SCALE: 1" = 20'

SURVEY ORDERED BY: LEWIS & LEVINSON
ATTORNEYS AT LAW
333 WEST STATE ROAD
ISLAND LAKE, IL 60042

I HEREBY CERTIFY THAT I HAVE SURVEYED THE ABOVE DESCRIBED PROPERTY AND THE ABOVE MAP IS A TRUE REPRESENTATION THEREOF AND SHOWS THE SIZE AND LOCATION OF THE PROPERTY, THE LOCATION OF ALL VISIBLE STRUCTURES AND DIMENSIONS OF ALL PRINCIPAL BUILDINGS THEREON, BOUNDARY FENCES, APPARENT EASEMENTS, ROADWAY AND VISIBLE ENCROACHMENTS, IF ANY.

THIS SURVEY IS MADE FOR THE PRESENT OWNERS OF THE PROPERTY AND ALSO THOSE WHO PURCHASE OR GUARANTEE THE TITLE THERETO WITHIN (1) YEAR FROM THE DATE HEREOF.

DATED AT WATERFORD THIS 26TH DAY OF AUGUST 1999

RECERTIFIED

[Signature]

TFR2-34
006-705