

PLAT OF SURVEY

OF

J.K. SURVEYING
JEFFREY L. KIMPS R.L.S.




7561 336TH AVE.
BURLINGTON WI 53105
262-537-4274

A PART OF LOT 1 OF FREEMAN'S ADDITION TO THE VILLAGE OF GENOA CITY, WALWORTH COUNTY, WISCONSIN ACCORDING TO THE RECORD PLAT THEREOF DESCRIBED AS FOLLOWS: COMMENCING AT THE NORTHWEST CORNER OF SAID LOT 1, THENCE SOUTH ALONG THE WEST LINE 70.83 FEET; THENCE EAST 73.68 FEET; THENCE NORTH 70.83 FEET TO THE NORTH LINE OF SAID LOT 1; THENCE WEST 71.68 FEET TO THE POINT OF BEGINNING.

PREPARED FOR :
BARBARA GOODNOUGH
KELLER WILLIAMS REALTY
ANTIOCH, ILL.

PROPERTY ADDRESS
480 FREEMAN ST
GENOA CITY, WI.

PARK STREET

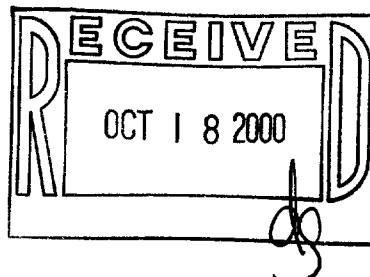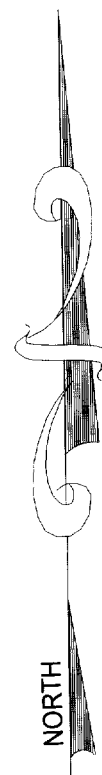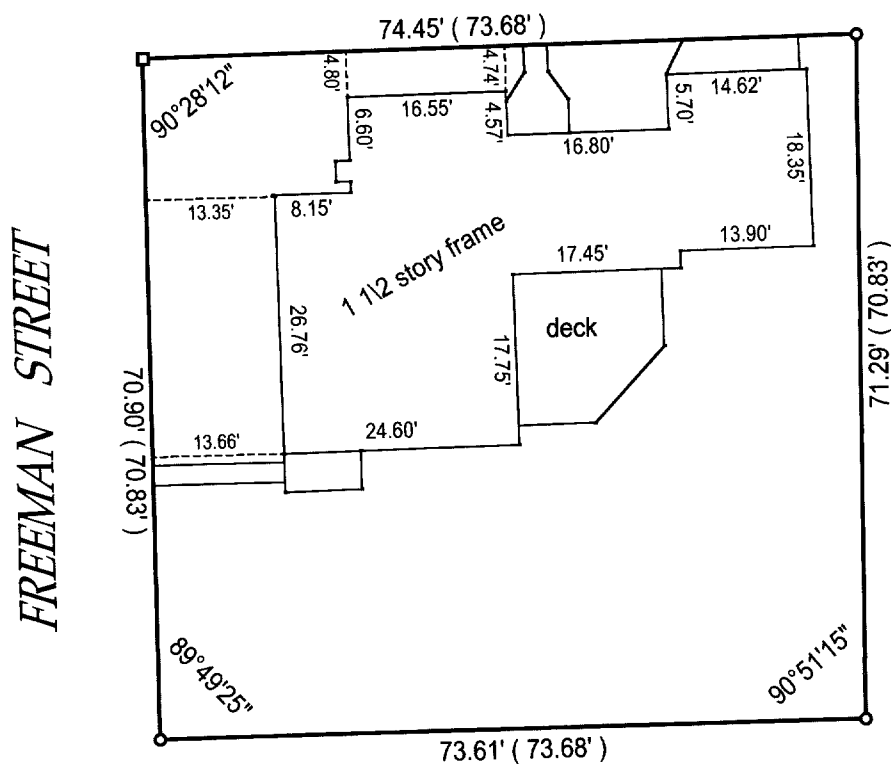

() = recorded as

■ = set iron bar

□ = found iron bar

○ = found iron pipe

● = set iron pipe

COMPARE LEGAL DESCRIPTION ABOVE AND DRAWING WITH DEED. FOR BUILDING RESTRICTIONS AND EASEMENTS NOT SHOWN, REFER TO DEED, ABSTRACT SOURCES AND LOCAL MUNICIPAL CODES. NOTIFY THE SURVEYOR IMMEDIATELY OF ANY DISCREPANCY.

"I hereby certify that I have surveyed the above described property and that the above map is a true representation thereof and shows the size and location of all visible structures, apparent easements and encroachments if any."

This survey is made for the present owners of the property, and those who purchase, mortgage, or guarantee the title thereto, within one year from the date hereof.

JOB# 00-269

SCALE: 1"=20'

TAX KEY #
TFR 00001

DATED THIS 22 TH DAY OF JUNE 2000

JEFFREY L. KIMPS S-2436-008

TFR-1

006-790