
FARRIS, HANSEN & ASSOCIATES, INC.

ENGINEERING, ARCHITECTURE, SURVEYING
7 RIDGEWAY COURT - P.O. BOX 437, ELKHORN, WISCONSIN, 53121

PLAT OF SURVEY

LOT 90 OF HUNTERS RIDGE SUBDIVISION

LOCATED IN ALL 1/4'S OF THE SW 1/4
SECTION 25, TOWN 1 NORTH, RANGE 18 EAST
VILLAGE OF GENOA CITY, WALWORTH COUNTY, WISCONSIN

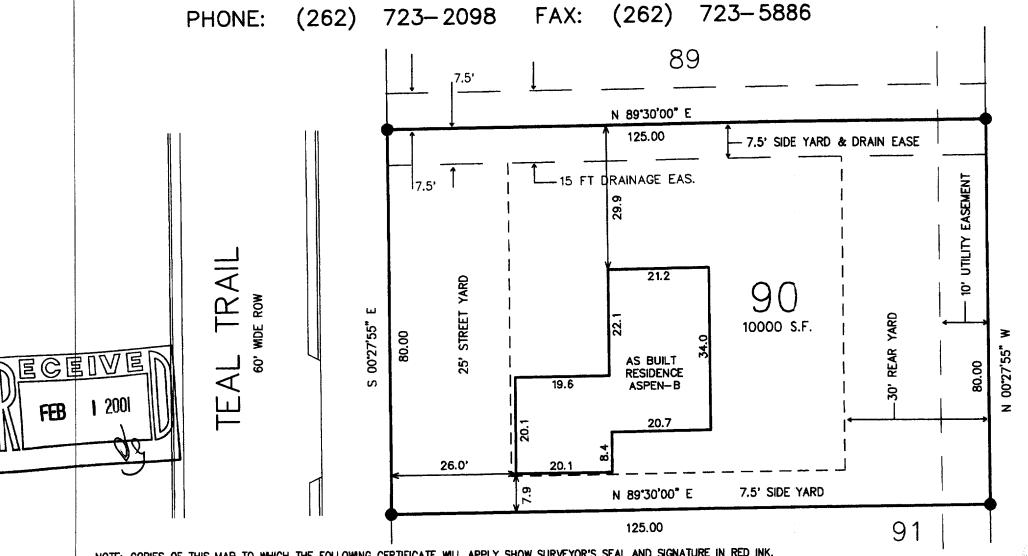

FOUND IRON REBAR STAKE
FOUND CONCRETE COUNTY MONUMENT

(XXXX)= PROPOSED TOP OF CURB ELEVATION

OUTLOT 3

SSIGNED N. LINE OF THE

NOTE: SIDE YARDS TOTAL 15' MINIMUM WITH 6' MINIMUM ALLOWABLE PER VILLAGE ORDINANCE.

WORK ORDERED BY: JOHN TRACY THE TRACY GROUP 506 W. OLD N.W. HWY. BARRINGTON, IL. 60010

NOTE: COPIES OF THIS MAP TO WHICH THE FOLLOWING CERTIFICATE WILL APPLY SHOW SURVEYOR'S SEAL AND SIGNATURE IN RED INK. COPIES BY ANY OTHER MEANS MAY HAVE ALTERATIONS WHICH DO NOT REPRESENT THE SURVEYOR'S WORK PRODUCT.

I HEREBY CERTIFY THAT THE ABOVE DESCRIBED PROPERTY HAS BEEN SURVEYED UNDER MY DIRECTION AND THAT THE ABOVE MAP IS A TRUE REPRESENTATION THEREOF AND SHOWS THE SIZE AND LOCATION OF THE PROPERTY, ITS EXTERIOR BOUNDARIES, THE LOCATION OF ALL VISIBLE STRUCTURES, AND DIMENSIONS OF ALL PRINCIPLE BUILDINGS THEREON, BOUNDARY FENCES, APPARENT EASEMENTS, ROADWAYS, AND VISIBLE ENCROACHMENTS, IF ANY. THIS SURVEY IS MADE FOR THE USE OF THE PRESENT OWNERS OF THE PROPERTY, AND ALSO THOSE WHO PURCHASE, MORTGAGE, OR GUARANTEE THE TITLE THERETO WITHIN ONE YEAR FROM THE DATE HEREOF.

DATED: 11-27-2000

REVISED 01-24-2001 TO SHOW SIZE & LOCATION OF RESIDENCE AS BUILT

PETER S. GORDON R.L.S. 2101

10 5 0 10 20 30 40 50 60 70 80 90 100 MAP SCALE IN FEET ORIGINAL 1" = 20'

PROJECT 4267.90

SHEET 1 OF 1

THR-90

006-836