


**REGISTERED PROFESSIONAL LAND SURVEYOR  
LAKE GENEVA, WISCONSIN**

FRANKLIN STREET 66' WIDE

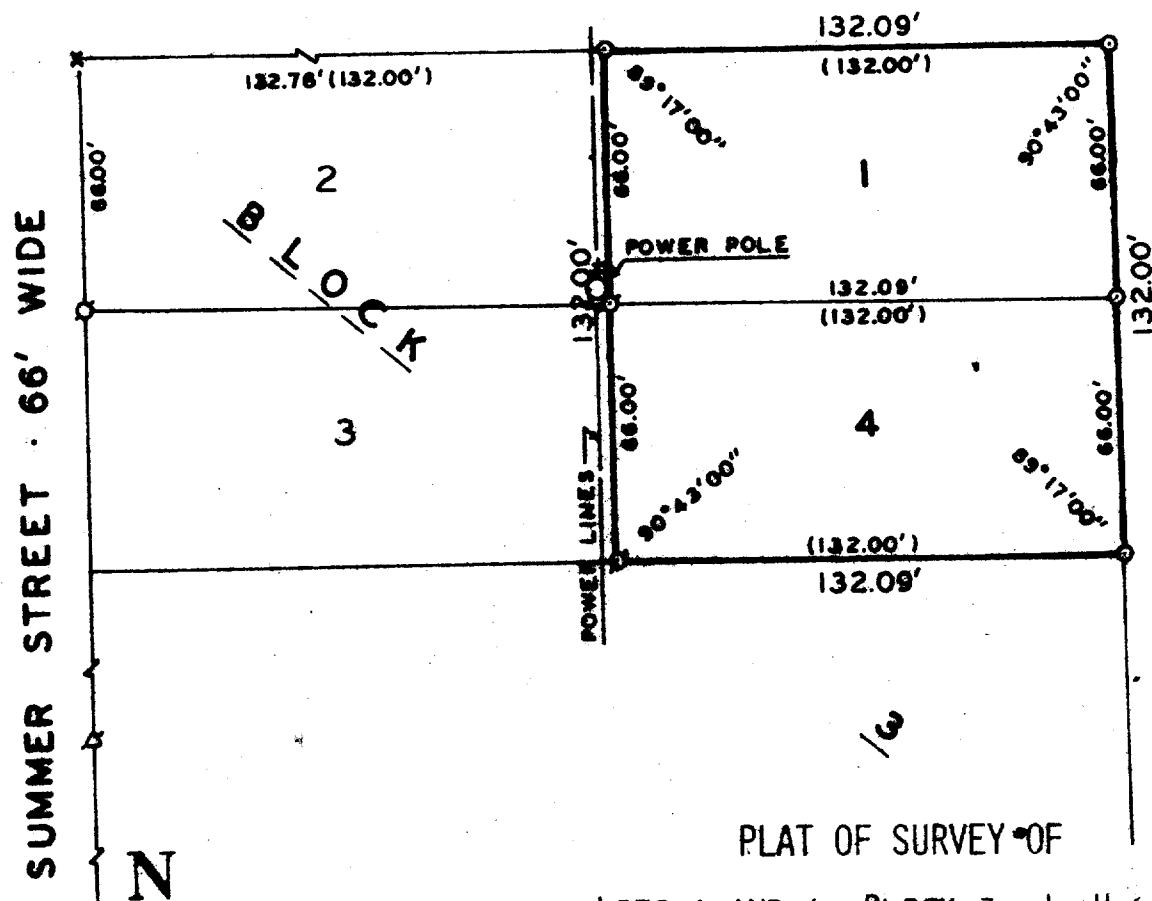

## PLAT OF SURVEY OF


LOTS 1 AND 4, BLOCK 3, J. H.  
 ROWE ADDITION, VILLAGE OF GENOA  
 CITY, WALWORTH COUNTY, WISCONSIN.

OWNER: BARRY MANDALL

ACCURACY: DISTANCES:  $\pm 0.01'$   
 ANGLES:  $\pm 05''$   
 ERROR OF CLOSURE: LESS  
 THAN ONE PART IN 3,000

I, Eugene Blomquist, DO HEREBY CERTIFY THAT I HAVE SURVEYED THE PROPERTY HEREON DESCRIBED ACCORDING TO THE OFFICIAL RECORDS, AND THAT THE PLAT HEREON IS A CORRECT REPRESENTATION OF THE LOT LINES.

EUGENE A. BLONQUIST  
WISCONSIN REGISTERED LAND SURVEYOR, S-187  
DATE June 29 1976

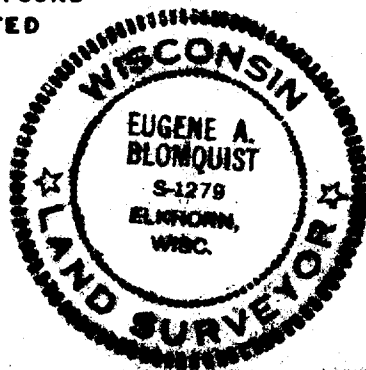

- Φ - IRON PIPE FOUND
- - IRON PIPE PLACED
- - CONCRETE MONUMENT
- X - SPIKE
- Δ - IRON ROD FOUND
- { } - AS PLATTED

**SCALE: 1" = 50'**

## LEGEND

IR-18.21

6-84