


PLAT OF SURVEY

BEGIN AT THE INTERSECTION OF THE EAST LINE OF THE WEST 1/2 OF THE NORTHWEST 1/4 OF THE SOUTHWEST 1/4 OF SECTION 16, TOWNSHIP 1 NORTH, RANGE 18 EAST, WITH THE NORTH LINE OF STATE TRUNK HIGHWAY AND FEDERAL HIGHWAY 12; GO THENCE WEST ALONG HIGHWAY 12, 150 FEET; THENCE NORTH 150 FEET PARALLEL TO SAID EAST LINE; THENCE EAST 150 FEET PARALLEL WITH THE NORTH LINE OF SAID HIGHWAY 12; THENCE SOUTH 150 FEET ALONG SAID EAST LINE TO THE PLACE OF BEGINNING, SAID LAND AND PREMISES BEING SITUATED IN THE VILLAGE OF GENOA CITY, WALWORTH COUNTY, WISCONSIN.

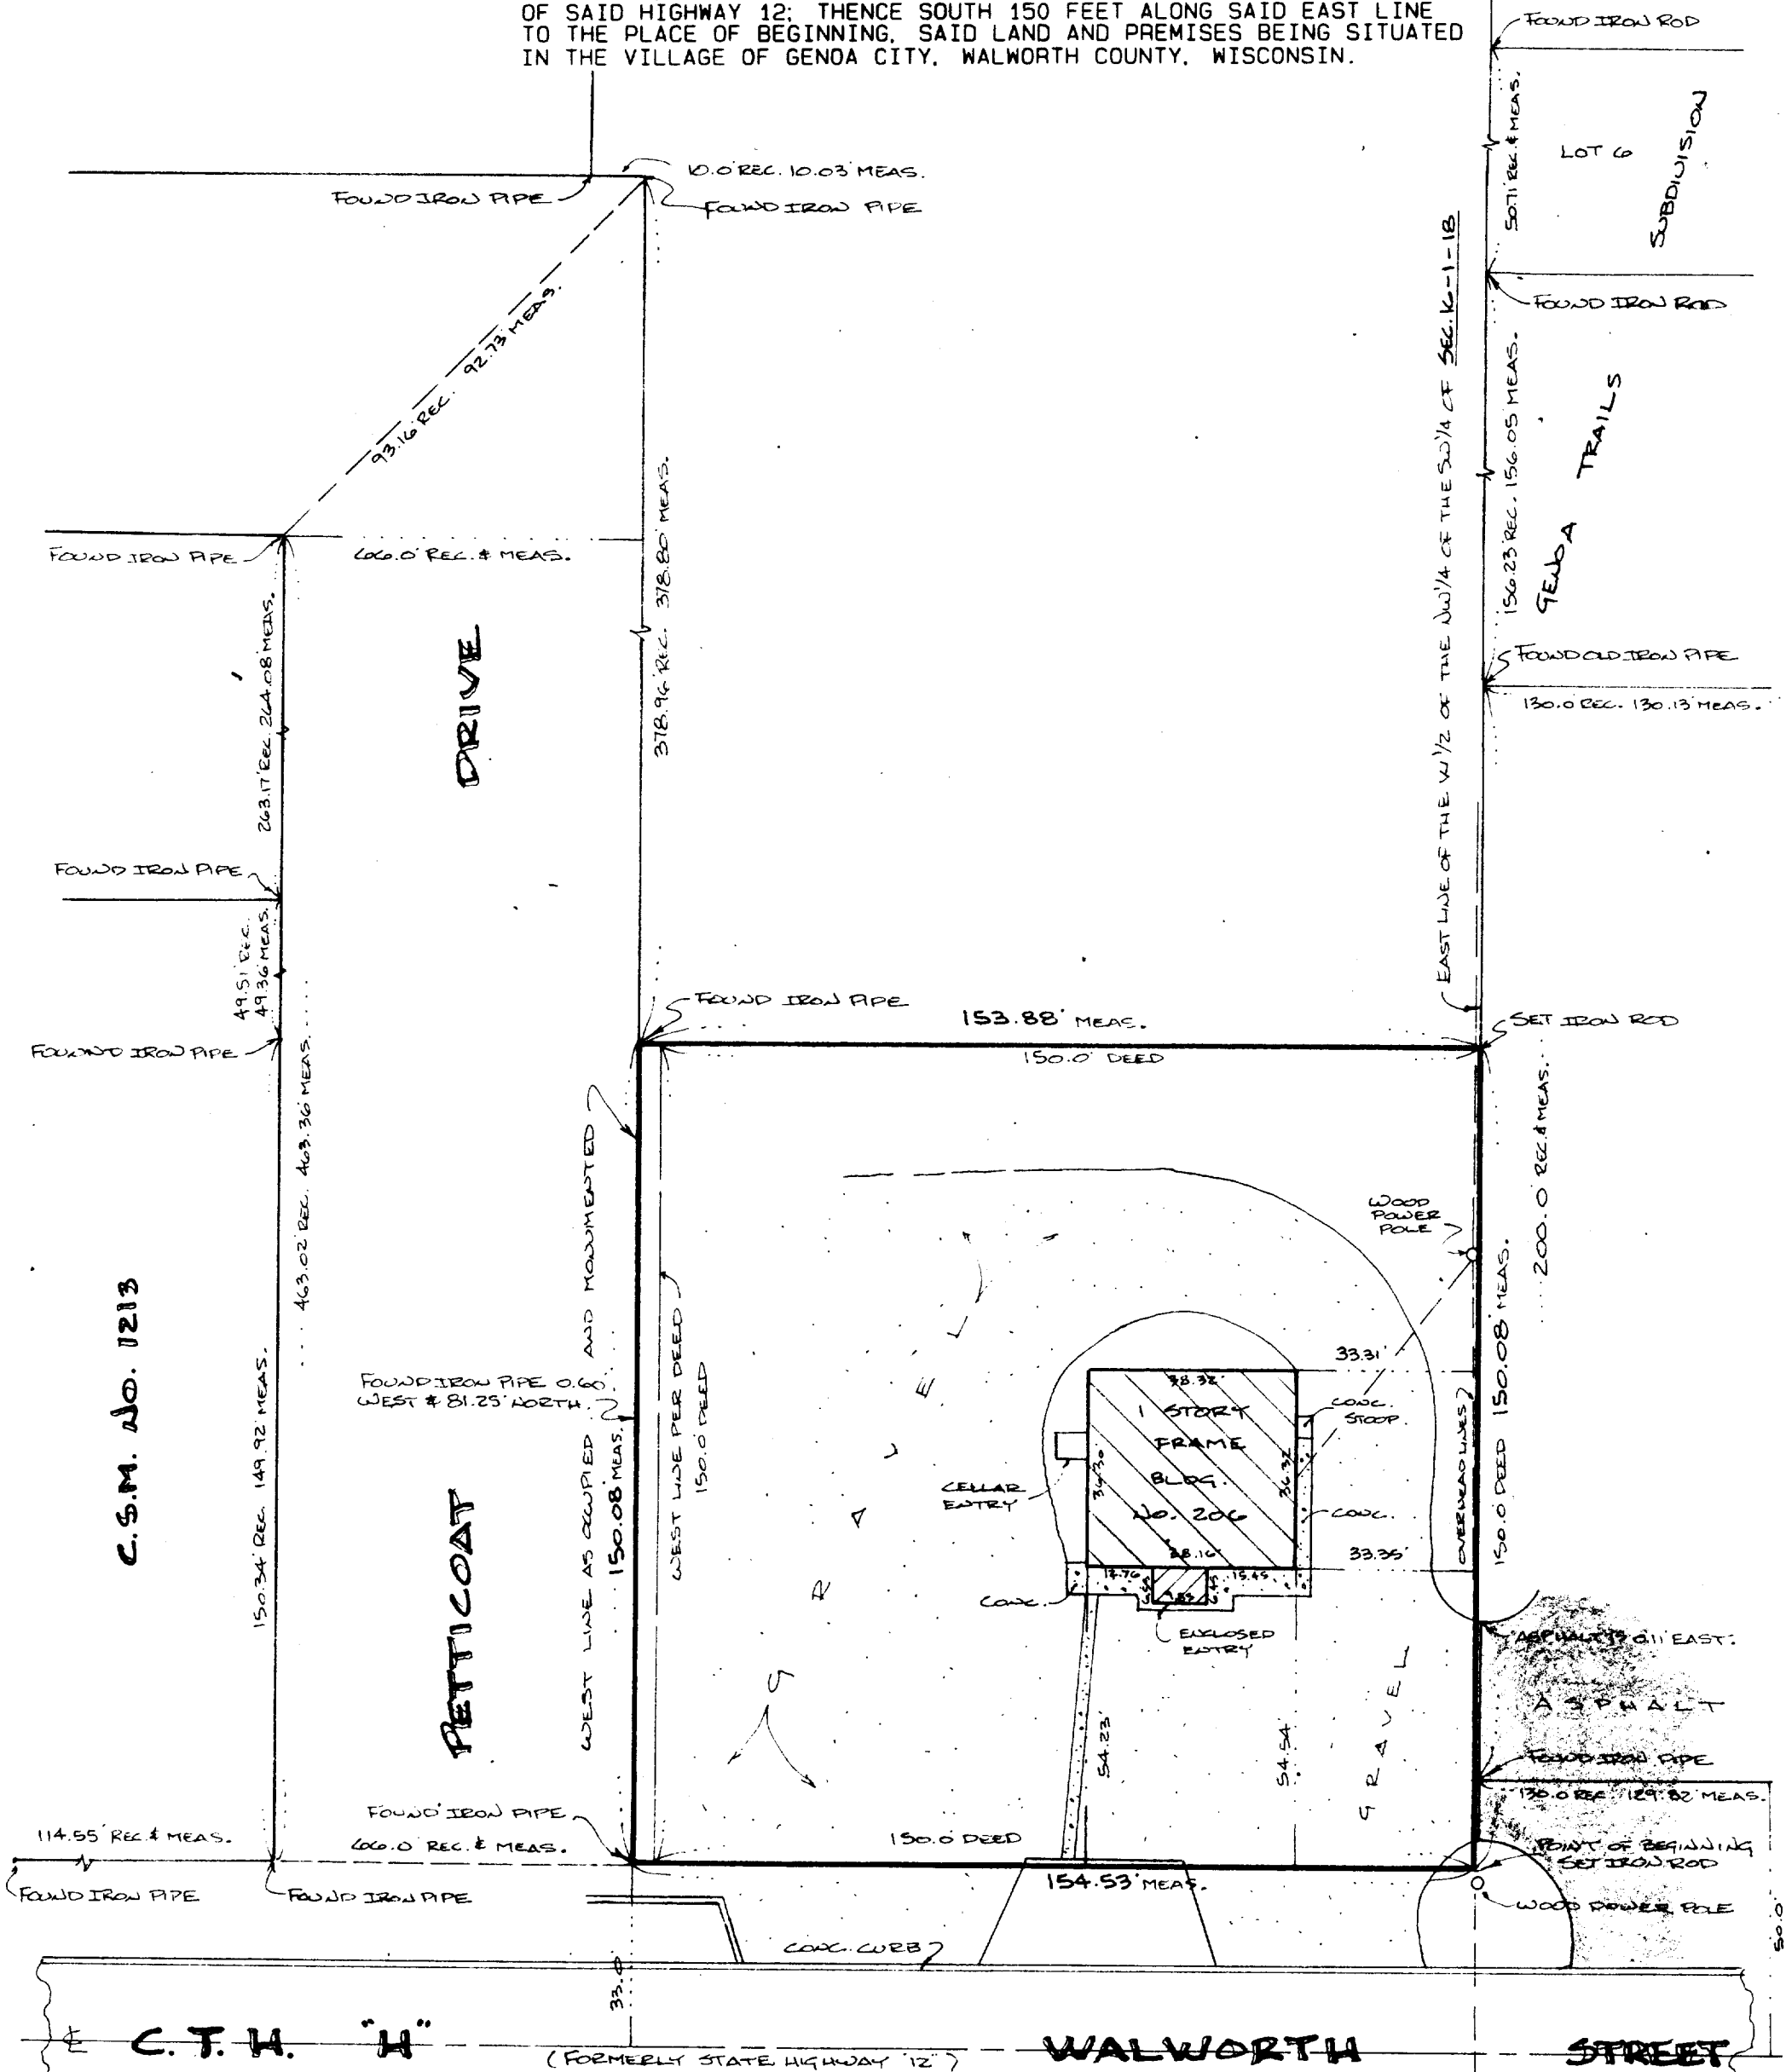

STATE OF ILLINOIS)
COUNTY OF LAKE) SS

MUNDELEIN, OCTOBER 4, 2000

THIS IS TO CERTIFY THAT I HAVE SURVEYED THE ABOVE DESCRIBED PROPERTY ACCORDING TO THE OFFICIAL RECORD, AND THAT THE ABOVE PLAT CORRECTLY REPRESENTS SAID SURVEY.

Steven M. Sloat
STEVEN M. SLOAT, WISCONSIN PROFESSIONAL LAND SURVEYOR NO. S-2398

COMPARE ALL POINTS AND REPORT ANY DIFFERENCE AT ONCE. BUILDING LINES AND EASEMENTS ARE SHOWN ONLY WHERE THEY ARE SO RECORDED IN THE MAPS. REFER TO YOUR DEED, ABSTRACT, TITLE POLICY OR BUILDING COMMISSIONER. DIMENSIONS ARE SHOWN IN FEET AND DECIMAL PARTS THEREOF. NO DIMENSION IS TO BE ASSUMED BY SCALING. THIS PLAT IS NOT VALID WITHOUT EMBOSSED SURVEYORS SEAL.


SURVEYED FOR:

WILLIAMSON REAL ESTATE
635 W. LIBERTY STREET
WAUCONDA, ILLINOIS

SCALE: 1" = 30'

ORDER NO.: WIS-00-80

TOP OF PLAT IS NORTH

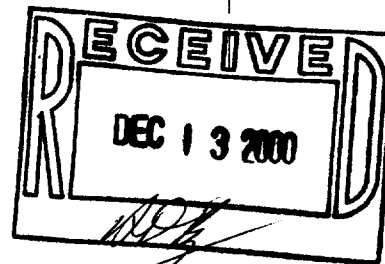

FREMONT LAND SURVEYING
& MAPPING, INC.

210 HIGHLAND DRIVE
MUNDELEIN, ILLINOIS 60060

TEL: (847)-566-0907 FAX: (847)-566-0977