
## PLAT OF SURVEY -OF-

LOT 8 IN BLOCK 4 OF FREEMAN'S SECOND ADDITION TO THE VILLAGE OF GENOA CITY, WALWORTH COUNTY, WISCONSIN.

SURVEY FOR: THE LAW OFFICES OF DAVID T. SMITH

SURVEY LOCATION: 409 WISCONSIN STREET

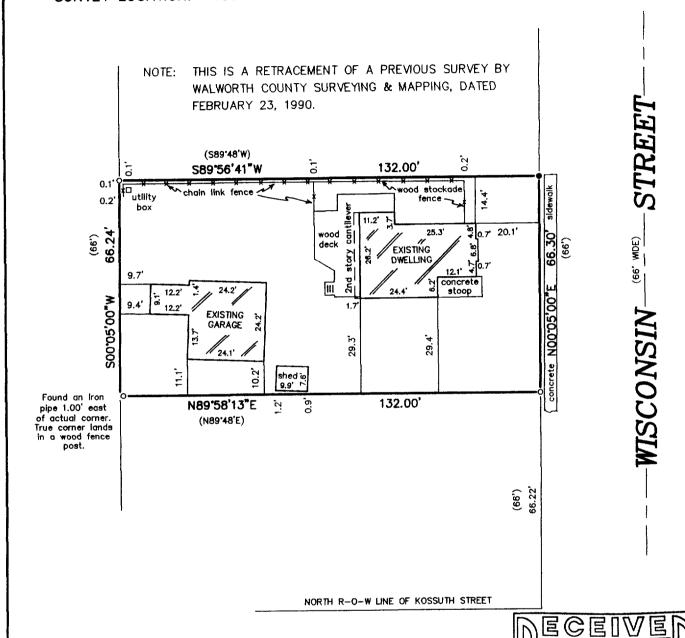

## LEGEND

- O FOUND IRON PIPE
- FOUND IRON ROD
- ( ) RECORDED AS


"I hereby certify that I have surveyed the above described property and that the above map is a correct representation thereof and shows the size and location of the property, its exterior boundaries, the location of all visible structures and dimensions of all principal buildings thereon, boundary fences, apparent easements, roadways and encroachments, if any."

"This survey is made for the use of the present owners of the property, and those who purchase, mortgage, or guarantee the title thereto within one year from date hereof."



## B.W. SURVEYING, INC.

412 N. PINE STREET BURLINGTON, WI 53105 (262)-767-0225

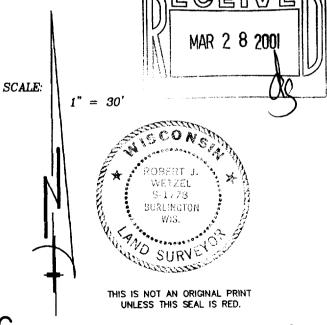

ROBERT J. WETZELS S-17

FEBRUARY 21, 2001 DATE 4820 JOB NUMBER

ODG-872

TFR2-14