

-OF-

SURVEY FOR: RE/MAX SOUTHERN LAKES REALTY
SURVEY LOCATION: 102 CHANCELLOR COURT

CHANCELLOR COURT

N88°24'40"E concrete roll-top curb 50.00'

8' wide utility and snow removal easement

22.2'

22.3'

4' wide utility easement

N01°24'54"W

15.9'

19.9'

22.7'

18.3'

common wall

25.7'

80.50'

80.87'

14.0'

9.3'

2.0'

5.3'

2.0'

6.9'

15.8'

chimney

EXISTING

34.1'

wood deck

14.2'

8' wide utility easement

S87°59'21"W

50.00'

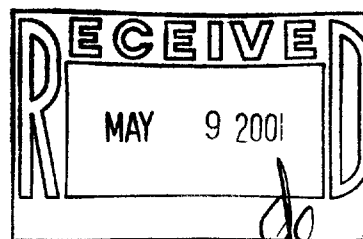
attached garage

DUPLEX

attached garage

concrete stoop

- FOUND IRON ROD
- FOUND IRON PIPE

$$1'' = 20'$$


"This survey is made for the use of the present owners of the property, and those who purchase, mortgage, or guarantee the title thereto within one year from date hereof."



412 N. PINE STREET
BURLINGTON, WI 53105
(262)-767-0225

Robert J. Wetzel
ROBERT J. WETZEL S-1778

APRIL 10, 2001
DATE

4925
JOB NUMBER



TGT-2 006-887