


-OF-

SURVEY FOR: SCOTT JOHNSON-RE/MAX GENEVA REALTY
SURVEY LOCATION: 454 RIDGEVIEW DRIVE

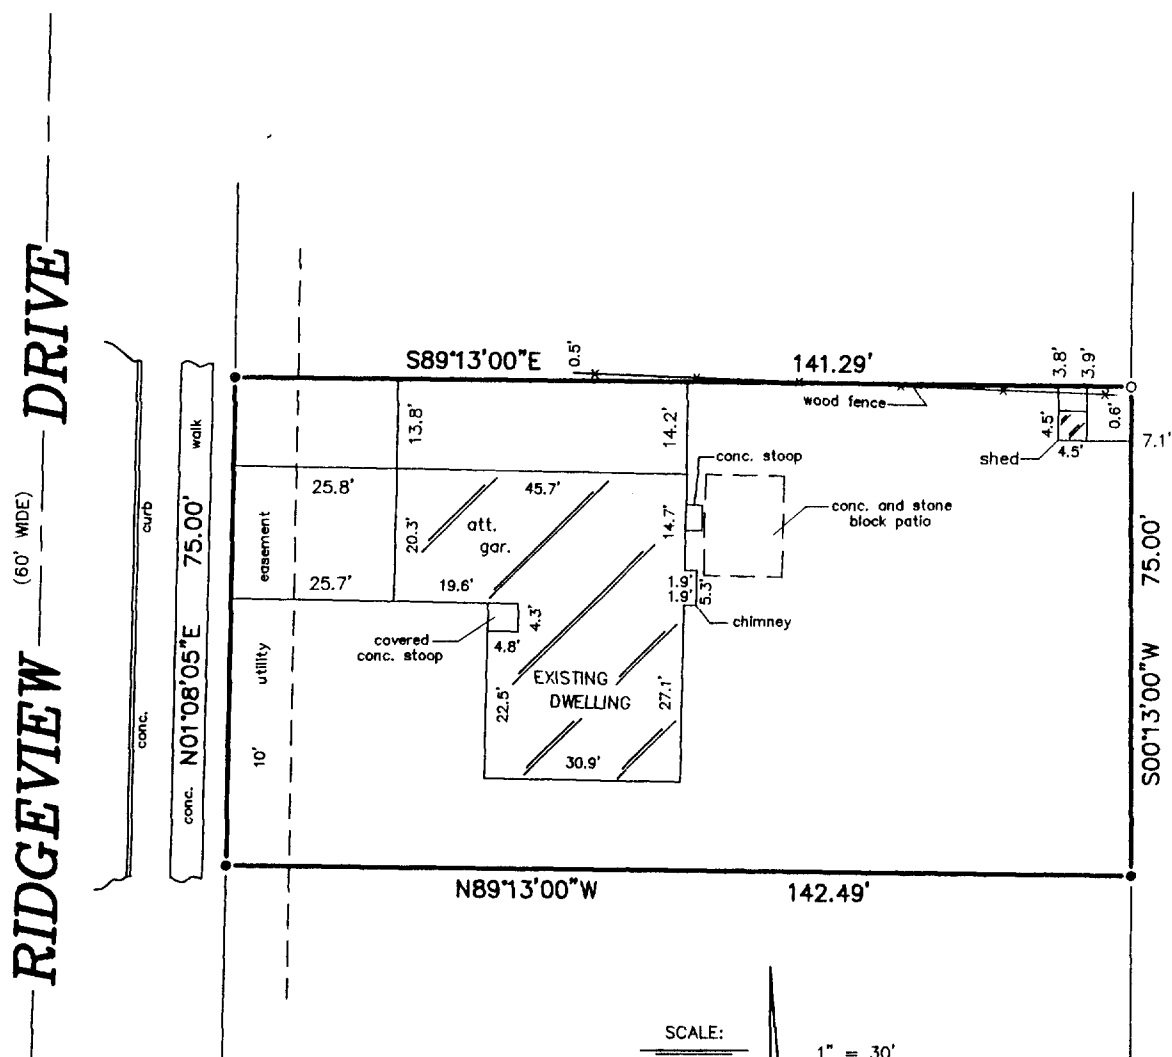

SCALE:



$$1'' = 30'$$

LEGEND


- FOUND IRON ROD
- SET IRON PIPE

"I hereby certify that I have surveyed the above described property and that the above map is a correct representation thereof and shows the size and location of the property, its exterior boundaries, the location of all visible structures and dimensions of all principal buildings thereon, boundary fences, apparent easements, roadways and encroachments, if any."

"This survey is made for the use of the present owners of the property, and those who purchase, mortgage, or guarantee the title thereto within one year from date hereof."

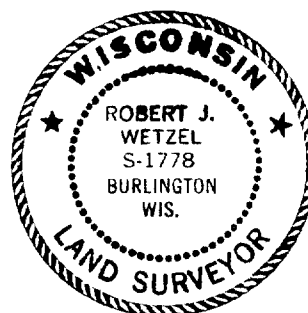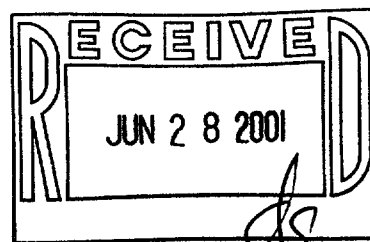

THIS IS NOT AN ORIGINAL PRINT
UNLESS THIS SEAL IS RED.

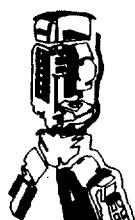

B.W. SURVEYING, INC.

412 N. PINE STREET
BURLINGTON, WI 53105
(262)-767-0225

Robert J. Wetzel
ROBERT J. WETZEL S-1778

MAY 15, 2001
DATE

4958
JOB NUMBER

TRID-65

PP6-908