

## WALWORTH COUNTY SURVEYING & MAPPING LAKE GENEVA, WISCONSIN

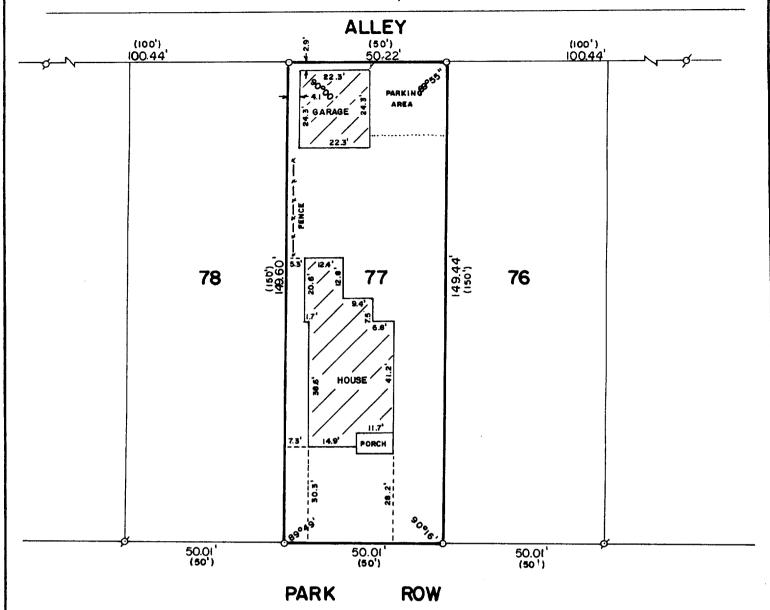

## PLAT OF SURVEY OF

LOT 77 OF COLUMBIAN SUBDIVISION, LOCATED IN THE CITY OF LAKE GENEVA, WALWORTH COUNTY, WISCONSIN.

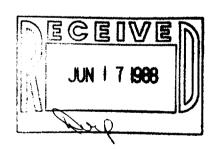

ORDERED BY: KEEFE REAL ESTATE

704 MAIN STREET

LAKE GENEVA, WISCONSIN

53147



SCALE: 1"=30'

ø-IRON PIPE FOUND o-IRON ROD PLACED

()-RECORDED AS

I, ROBERT M. BAERENWALD, DO HEREBY CERTIFY THAT I HAVE SURVEYED THE PROPERTY HEREON DESCRIBED ACCORDING TO THE OFFICIAL RECORDS AND THAT THE PLAT HEREON IS A CORRECT REPRESENTATION OF THE PROPERTY LINES TO THE BEST OF MY KNOWLEDGE AND BELIEF.

ROBERT M. BAERENWALD

WISCONSIN REGISTERED LAND SURVEYOR, S-1508

DATE JOB NO. 1486

NOTE: THIS IS NOT A CERTIFIED COPY UNLESS SEALED.

2CL-65