


DUNHAM SURVEYING, S.C.
SURVEYING & SUBDIVIDING
DELAVER, WISCONSIN 53115

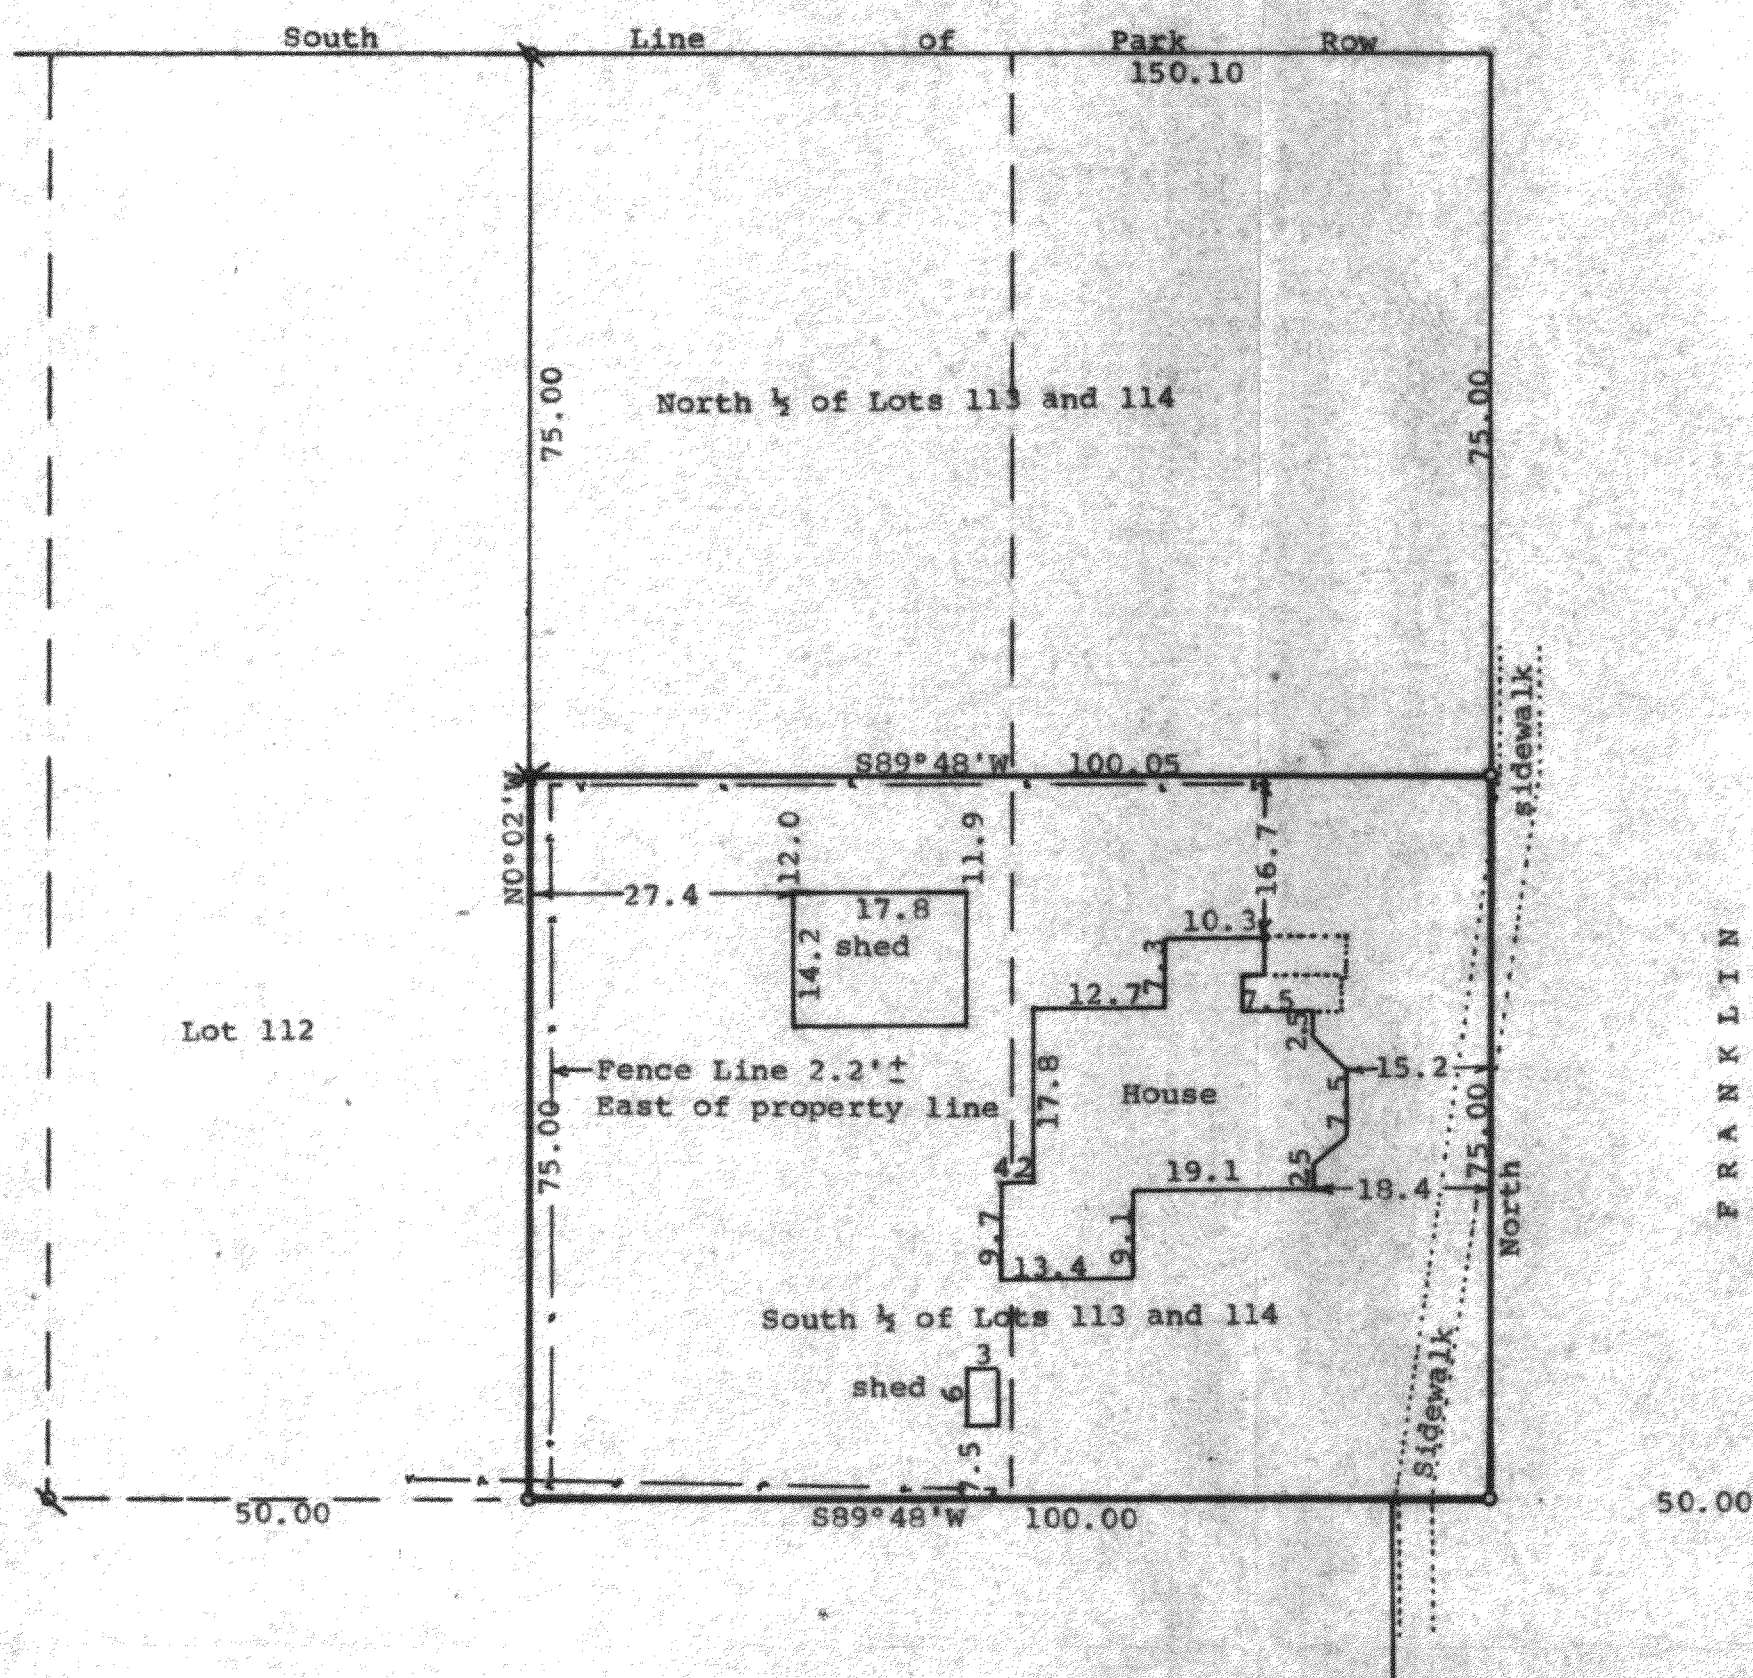

Scale - 1" = 20'
 ● = concrete monument found
 ○ = 1 1/2" Iron Pipe Found
 ○ = 1" Iron Pipe Found
 X = 1" Iron Pipe Found and reset
 ○ = 3/4" X 24" Iron Pipe Set
 --- = Fence Line
 Bearings reference to the west line of Franklin Street with the assumed bearing of North
 Survey ordered by: Redell Realty
 506 Madison
 Lake Geneva, WI 53147


STATE OF WISCONSIN)
COUNTY OF WALWORTH) SS

I, George T. Dunham, Surveyor, certify that I have surveyed the property described as follows:

The South 1/2 of Lots 113 and 114 in Columbian Subdivision in the City of Lake Geneva, Walworth County, Wisconsin,

and that the plat shown hereon is a correct representation thereof and shows the size and location of the property, its exterior boundaries, the location of all visible structures and dimensions of all principal buildings thereon, boundary fences, apparent easements, roadways and visible encroachments, if any, and that I have surveyed the property hereon described, according to the official records, to the best of my knowledge and belief.

April 25, 1988

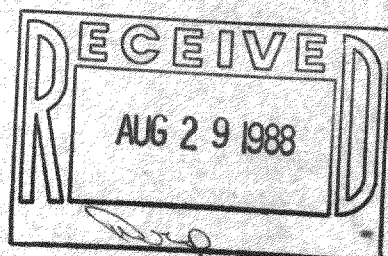

George T. Dunham
George T. Dunham, Surveyor

