


WALWORTH COUNTY  
SURVEYING & MAPPING  
LAKE GENEVA, WISCONSIN

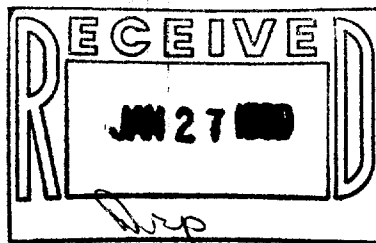



Brought in by  
William Cooper of  
Southeastern Wisconsin  
Title Corp.

PLAT OF SURVEY OF

A BUILDING LOCATED ON A PARCEL OF LAND  
IN THE SOUTHWEST 1/4 OF SECTION 25, T 2 N,  
R 17 E, CITY OF LAKE GENEVA, WALWORTH  
COUNTY, WISCONSIN.

ORDERED BY: STURG TAGGART AGENCY  
736 MAIN STREET  
LAKE GENEVA, WISCONSIN

NOTE: HEAVY LINE DENOTES BOUNDARY OF  
LANDS PURCHASE FROM RAILROAD.

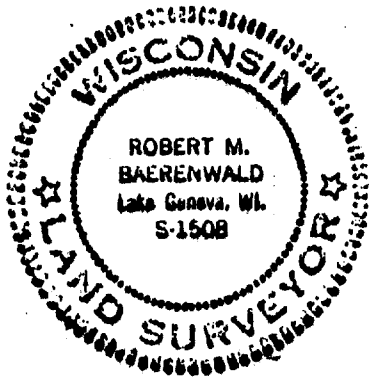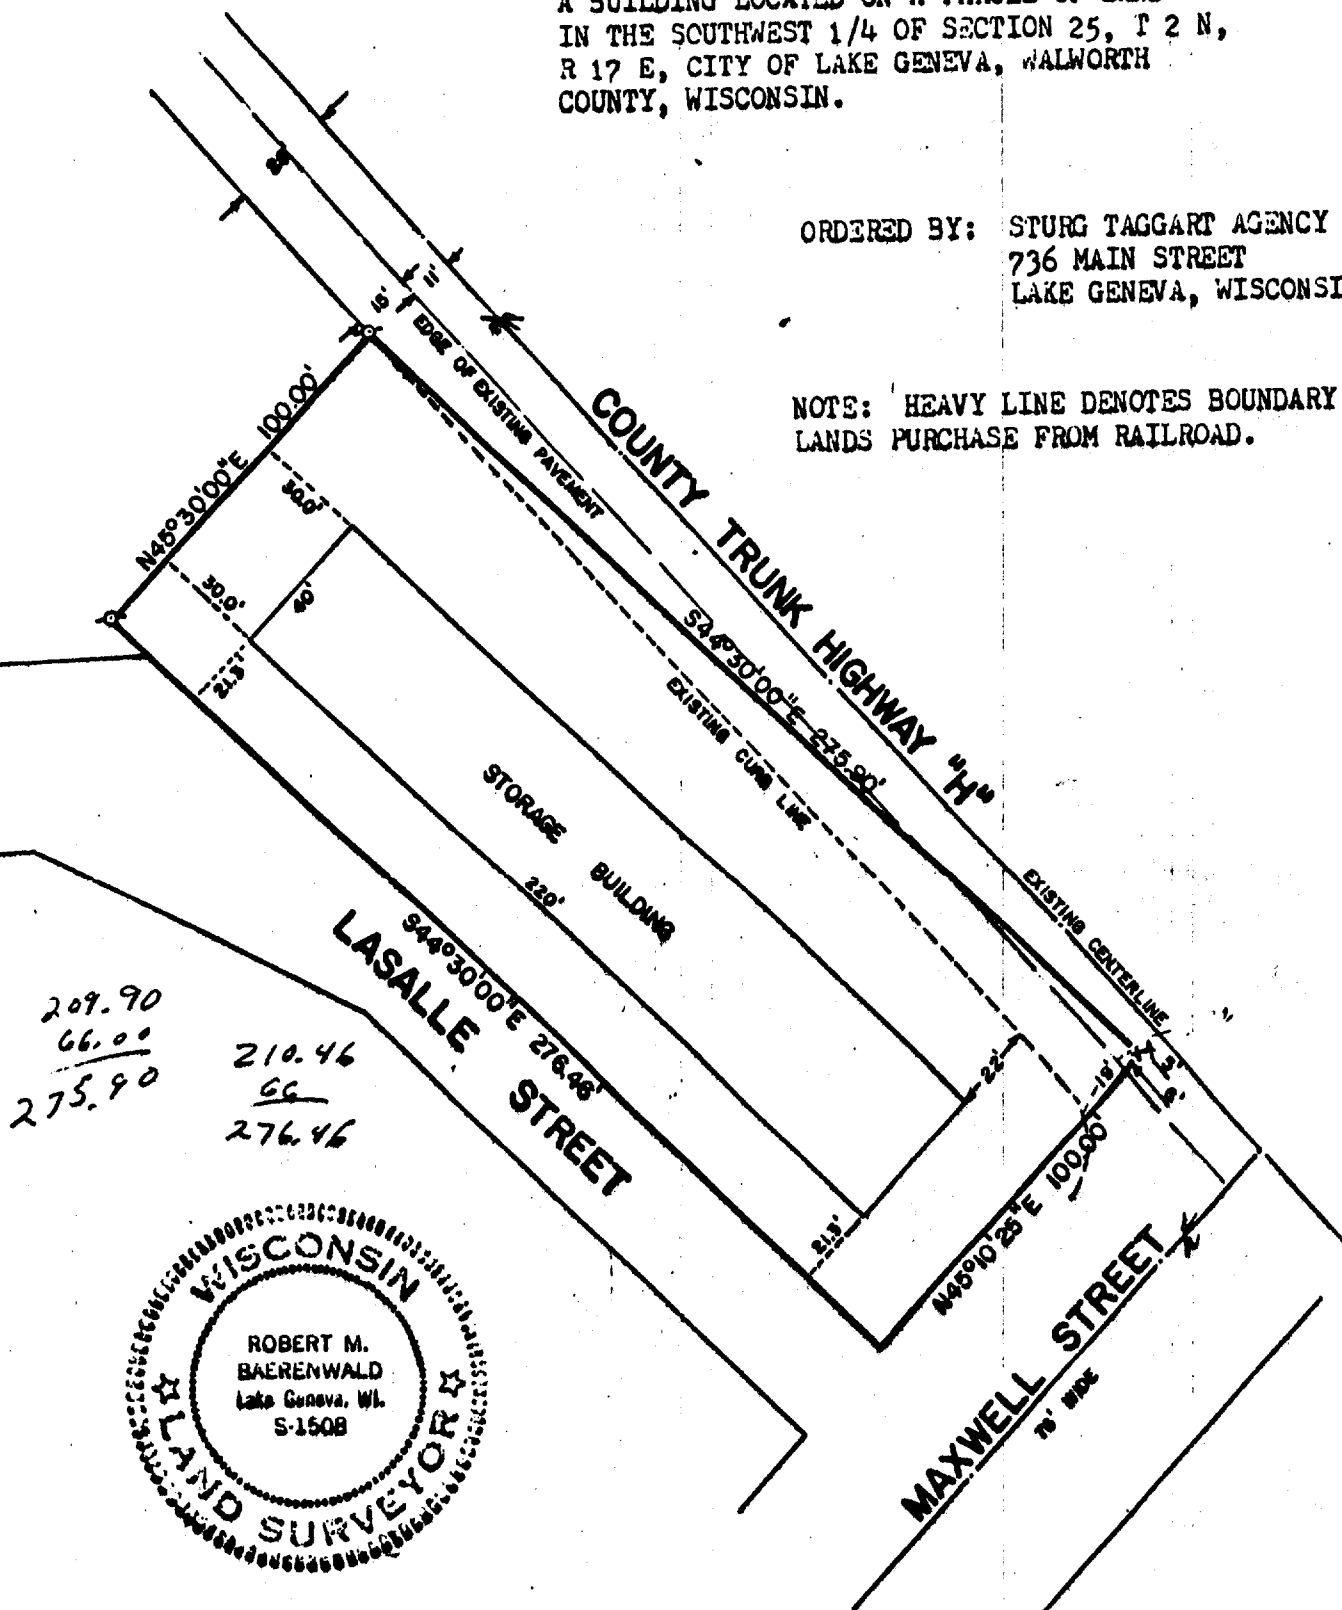

I, ROBERT M. BAERENWALD, DO HEREBY CERTIFY THAT I  
HAVE SURVEYED THE PROPERTY HEREON DESCRIBED ACCORDING  
TO THE OFFICIAL RECORDS AND THAT THE PLAT HEREON IS A  
CORRECT REPRESENTATION OF THE PROPERTY LINES TO THE  
BEST OF MY KNOWLEDGE AND BELIEF.

Robert M. Baerenwald  
ROBERT M. BAERENWALD  
WISCONSIN REGISTERED LAND SURVEYOR, S-1508

Nov. 7, 1984  
DATE JOB NO. 0009

REVISED: JUNE 25, 1985

Lake Geneva



SCALE: 1"=50'

⊕ - IRON PIPE FOUND  
\* - P. K. NAIL

ZYUP - 41K

7-1142