


929 WILLIAMS STREET LAKE GENEVA, WISCONSIN 53147 414-248-3697



### LEGEND

- ϕ - IRON PIPE FOUND  
 SW - SIDE WALK  
 Δ -- UTILITY POLE  
 — -- OVERHEAD UTILITY  
 LINE

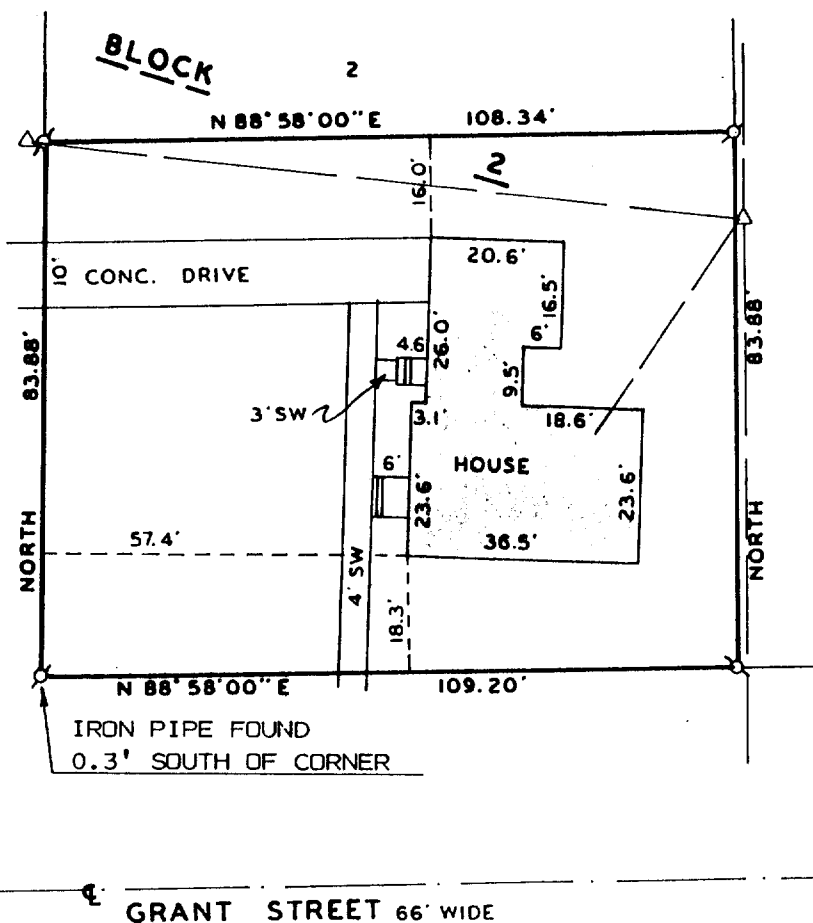

PLAT OF SURVEY OF

ORDERED BY: MRS. PAUL CHRISTOFFERSON  
927 GRANT STREET  
LAKE GENEVA, WI. 53147

SURVEY NOT VALID UNLESS SURVEYOR'S SIGNATURE  
IS IN RED.

REVISÉ.

