


# PLAT OF SURVEY

OF LOT 1 BLOCK 26 IN GENEVA - LAKE CRAWFORD MFG. CO.'S ADDITION IN PART OF SECTION 25.  
TOWNSHIP 2 NORTH, RANGE 17 EAST, IN WALWORTH COUNTY WISCONSIN.


SAGE ST

(BLACKTOP)

CONC. CURB AND GUTTER

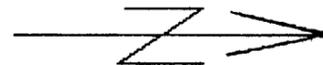

SCALE 1" = 20'

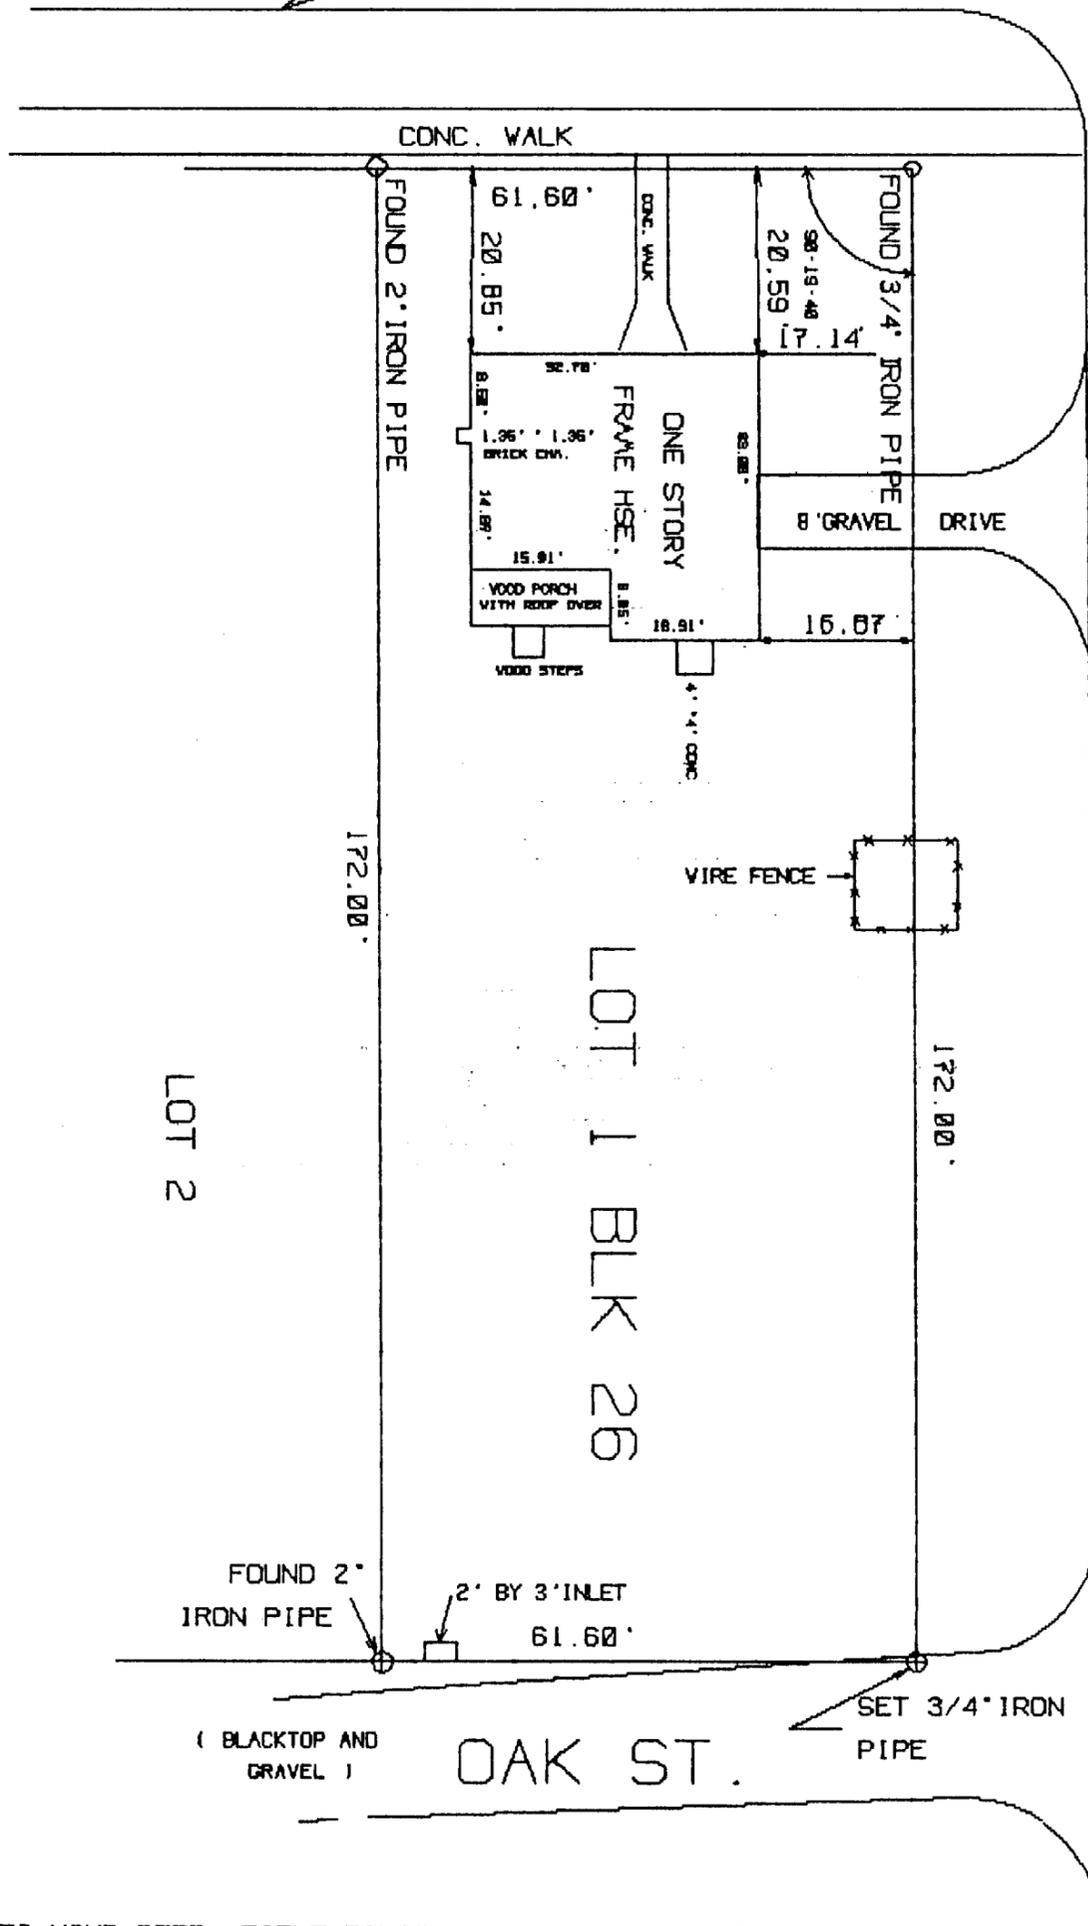

LOT 2

LOT 1 BLK 26

WATER ST (BLACKTOP)

FOUND 2" IRON PIPE

2' BY 3' INLET  
61.60'

(BLACKTOP AND GRAVEL)

OAK ST.


SET 3/4" IRON PIPE

NOTES:

- PLEASE REFER TO YOUR DEED, TITLE POLICY, OR LOCAL BUILDING AND ZONING RESTRICTIONS FOR BUILDING LINES, RESTRICTIONS, AND/OR EASEMENTS NOT SHOWN HEREON.
- ON RECEIPT OF THIS SURVEY AND YOUR INSPECTION OF THE SURVEY MARKERS, REPORT ANY APPARENT DISCREPANCY TO THE SURVEYOR IMMEDIATELY.

STATE OF ILLINOIS  
COUNTY OF MCHENRY

I HEREBY CERTIFY THAT I HAVE SURVEYED THE ABOVE DESCRIBED PROPERTY, AND THAT THE PLAT HEREON DRAWN IS A CORRECT REPRESENTATION OF SAID SURVEY. DATED 7-2-90

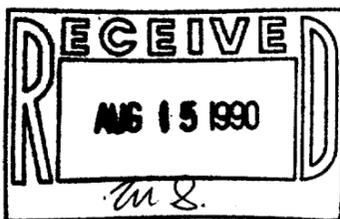

*Kenneth B. Vanagas*  
KENNETH B. VANAGAS  
PROFESSIONAL LAND SURVEYOR  
WISCONSIN NO. 1420