
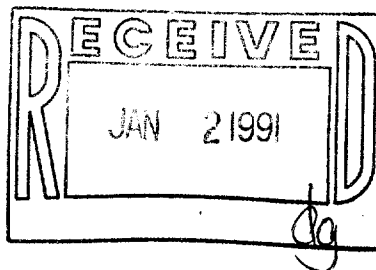



WALWORTH COUNTY  
SURVEYING & MAPPING  
LAKE GENEVA, WISCONSIN  
414-248-0505

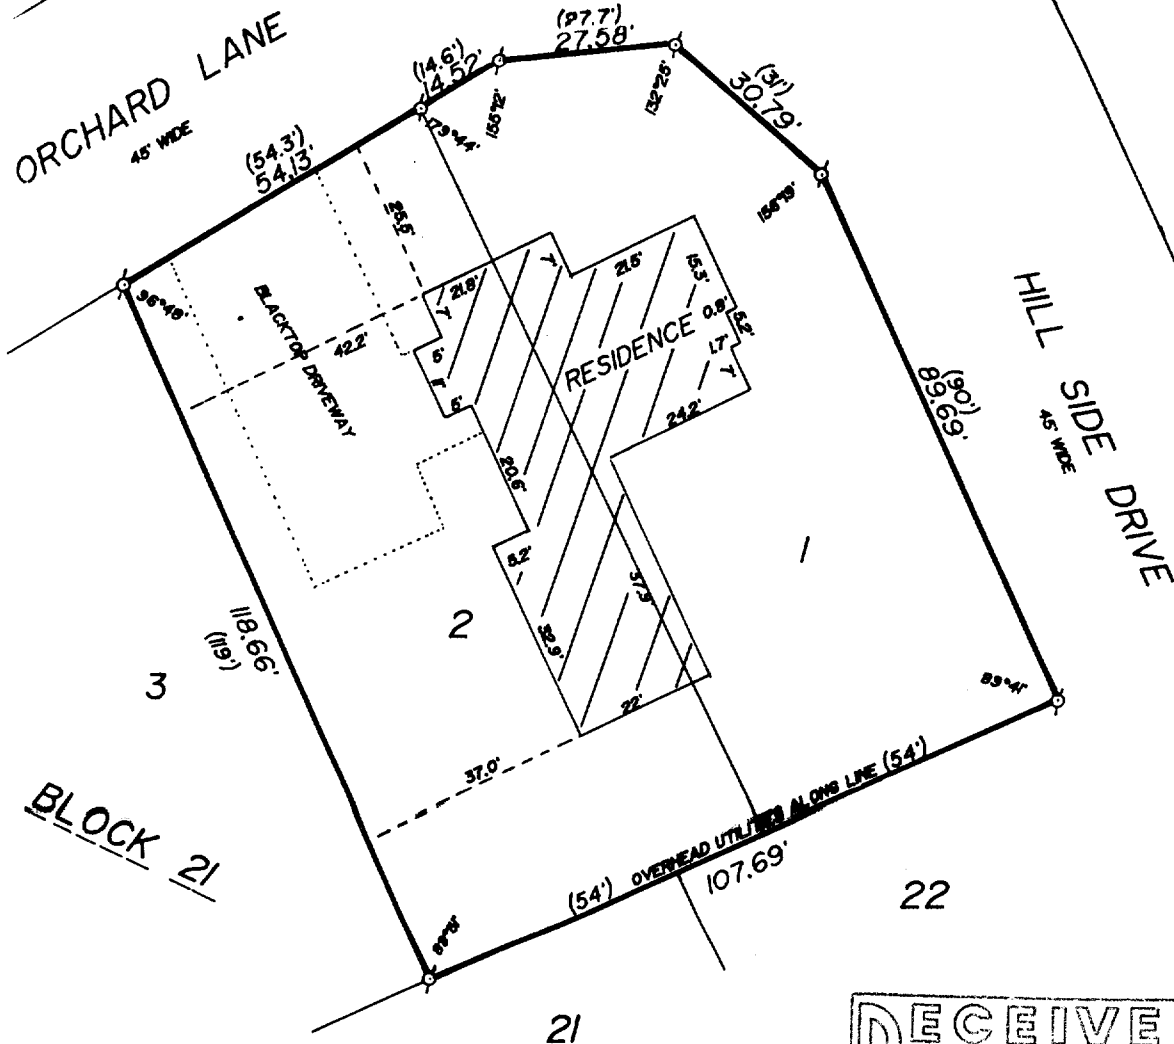

PLAT OF SURVEY OF

LOTS 1 AND 2, BLOCK 21 OF LAKE GENEVA MANOR,  
LOCATED IN THE CITY OF LAKE GENEVA, WALWORTH  
COUNTY, WISCONSIN.

ORDERED BY: VACATION PROPERTIES NETWORK  
101 BROAD STREET  
LAKE GENEVA, WISCONSIN  
53147

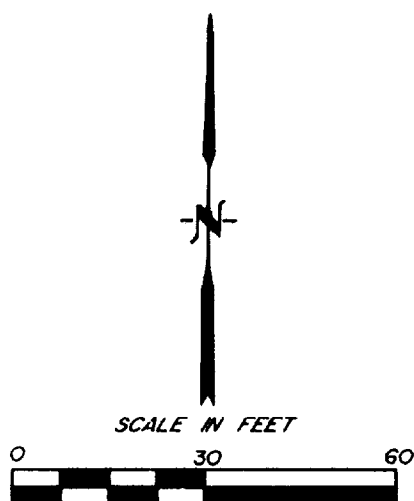

⊘ - IRON PIPE FOUND  
( ) - RECORDED AS

I HEREBY CERTIFY THAT I HAVE SURVEYED THE ABOVE DESCRIBED PROPERTY AND THAT  
THE ABOVE MAP IS A TRUE REPRESENTATION THEREOF AND SHOWS THE SIZE AND  
LOCATION OF THE PROPERTY, ITS EXTERIOR BOUNDARIES, THE LOCATION OF ALL VISIBLE  
STRUCTURES AND IMPOSITIONS OF ALL PRINCIPAL AND OTHER TITLES, EASEMENTS, RIGHTS,  
APPURTENANCES AND ROADWAYS AND VISIBLE ENCUMBRANCES, IF ANY, TO THE  
BEST OF MY KNOWLEDGE AND BELIEF.

THIS SURVEY IS MADE FOR THE USE OF THE PRESENT OWNERS OF THE PROPERTY AND  
ALSO THOSE WHO PURCHASE, MORTGAGE OR GUARANTEE THE TITLE THEREIN WITHIN  
ONE (1) YEAR FROM DATE HEREOF.

*Robert M. Baerwald*  
ROBERT M. BAERWALD  
WISCONSIN REGISTERED LAND SURVEYOR S-1508

DATE *Oct. 4, 1989* JOB NO. 2186

NOTE: THIS IS NOT A CERTIFIED COPY UNLESS SEALED

Survey # 007-1173

TAX KEY# 21444450