

SHEET 1 OF 2 SHEETS

(WEST 341')  
339.99'

**WILLOW STREET**  
(942) 204-1100  
62.32

**963.32'**

**BLACKTOP DRIVEWAY**

WIRE FENCE

**1.926 ACRES**



PROPERTY LINE AS SHOWN ON  
SURVEY BY H. KOLB DATED  
JAN. 25, 1974

ORDERED BY: FRANK CAMODECA  
601 LEE  
DES PLAINS, ILLINOIS  
60016

PLAT RECERTIFIED: JAN. 16, 1990  
FOR: VACATION PROPERTIES NETWORK  
101 BROAD STREET  
LAKE GENEVA, WISCONSIN  
53147

PLAT OF SURVEY OF

A PARCEL OF LAND LOCATED IN THE NORTHEAST  
1/4 OF SECTION 1, T 1 N, R 17 E, CITY OF  
LAKE GENEVA, WALWORTH COUNTY, WISCONSIN.

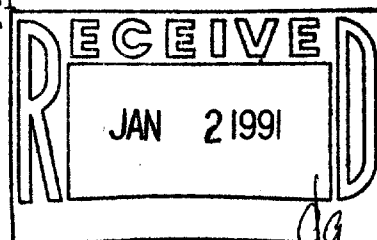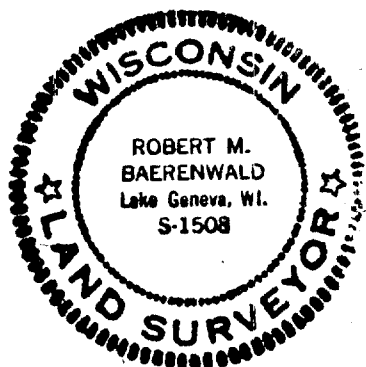

**SHEET 1 REVISED: JUNE 21, 1989 TO SHOW HOUSE LOCATION.**

I HEREBY CERTIFY THAT I HAVE SURVEYED THE ABOVE DESCRIBED PROPERTY AND THAT THE ABOVE MAP IS A TRUE REPRESENTATION THEREOF AND SHOWS THE SIZE AND LOCATION OF THE PROPERTY, ITS EXTERIOR BOUNDARIES, THE LOCATION OF ALL VISIBLE STRUCTURES AND DIMENSIONS OF ALL PRINCIPAL BUILDINGS THEREON, BOUNDARY FENCES, APPARENT EASEMENTS AND ROADWAYS AND VISIBLE ENCROACHMENTS, IF ANY.

THIS SURVEY IS MADE FOR THE EXCLUSIVE USE OF THE PRESENT OWNERS OF THE PROPERTY, AND ALSO THOSE WHO PURCHASE, MORTGAGE, OR GUARANTEE THE TITLE THERETO WITHIN ONE (1) YEAR FROM DATE HEREOF.

SCALE: 1"=50'

- Ø -IRON PIPE FOUND
- Ø -IRON ROD FOUND
- Ø -CONCRETE MONUMENT FOUND
- -IRON ROD PLACED
- ( ) -RECORDED AS

ROBERT M. BAERENWALD  
WISCONSIN REGISTERED LAND SURVEYOR, S-1508

DATE 11/11/97 JOB NO. 1997

NOTE: THIS IS NOT A CERTIFIED COPY UNLESS SEALED.

007-1229

ZYUPOO 100 B