


ABELL  
SURVEYING & MAPPING  
DELAVER, WISCONSIN 53115  
414-728-6737

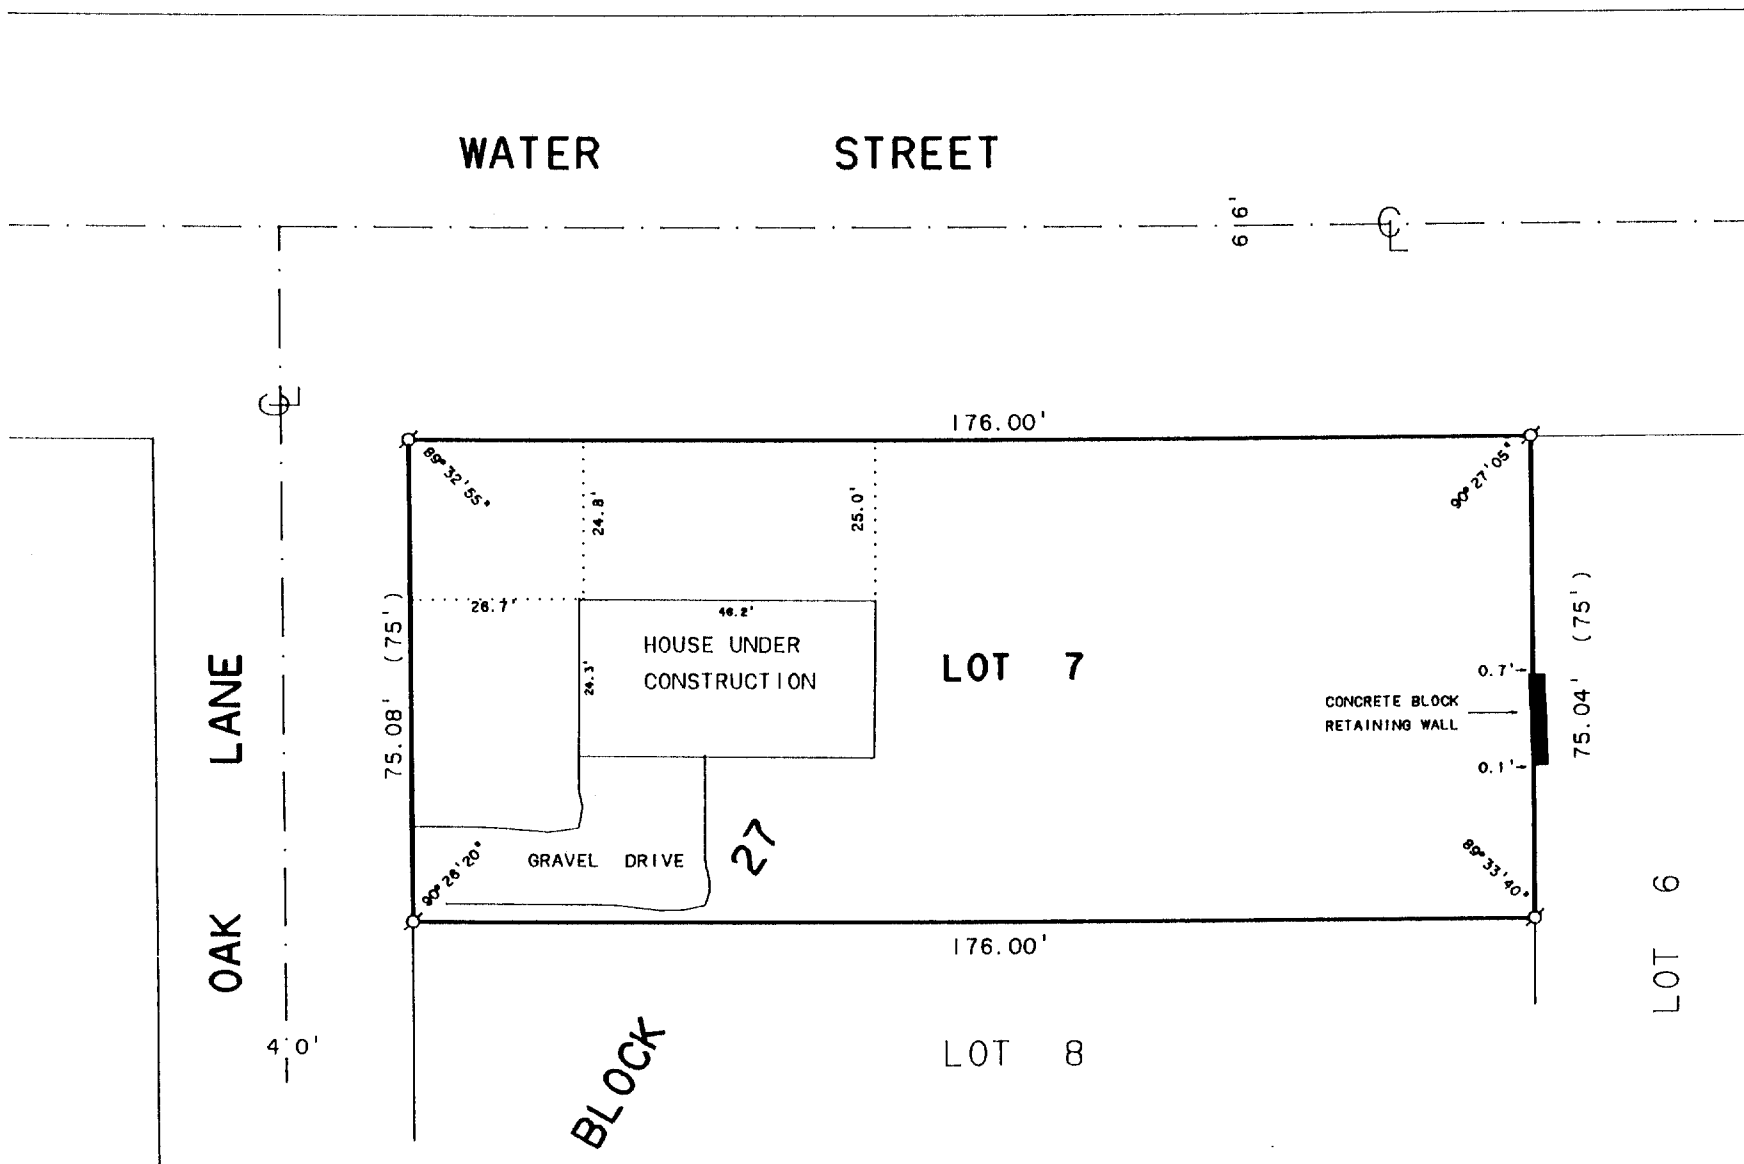

PLAT OF SURVEY OF

LOT 7, BLOCK 27, GENEVA LAKE CRAWFORD MANUFACTURING  
COMPANY ADDITION TO THE CITY OF LAKE GENEVA,  
WALWORTH COUNTY, WISCONSIN.


ORDERED BY: ANCHOR SAVINGS & LOAN  
P.O. BOX 997  
LAKE GENEVA, WI. 53147



SCALE - 1" = 30'

LEGEND

Ø - IRON PIPE FOUND  
( ) - RECORDED AS

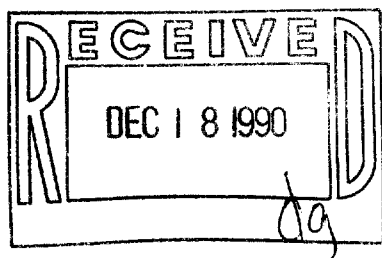

I HEREBY CERTIFY THAT I HAVE SURVEYED THE ABOVE DESCRIBED PROPERTY AND THAT THE ABOVE MAP IS A TRUE REPRESENTATION THEREOF AND SHOWS THE SIZE AND LOCATION OF THE PROPERTY, ITS EXTERIOR BOUNDARIES, THE LOCATION OF ALL VISIBLE STRUCTURES AND DIMENSIONS OF ALL PRINCIPAL BUILDINGS THEREON, BOUNDARY FENCES, APPARENT EASEMENTS, ROADWAYS AND VISIBLE ENCROACHMENTS, IF ANY, TO THE BEST OF MY KNOWLEDGE AND BELIEF.

THIS SURVEY IS MADE FOR THE USE OF THE PRESENT OWNERS OF THE PROPERTY, AND ALSO THOSE WHO PURCHASE, MORTGAGE, OR GUARANTEE THE TITLE THERETO WITHIN ONE (1) YEAR FROM DATE HEREOF.

*David F. Abell*  
DAVID F. ABELL

WISCONSIN REGISTERED LAND SURVEYOR, S-1596

*November 21, 1990*

DATE JOB NUMBER - 90220  
NOTE: THIS IS NOT A CERTIFIED COPY UNLESS SEALED.

007-1240

ZGC 00175