


REPL. PRINTED ON NO. 1000 CLEARPRINT

PLAT OF SURVEY

The North Half ($N\frac{1}{2}$) of Lots 5 and 6 in Block 11, in ORIGINAL PLAT OF THE
CITY OF LAKE GENEVA, in NW $\frac{1}{4}$ of Section 36, Township 2 North, Range 17 East, of FOURTH PRINCIPAL MERIDIAN
in Walworth County, State of Wisconsin.

N

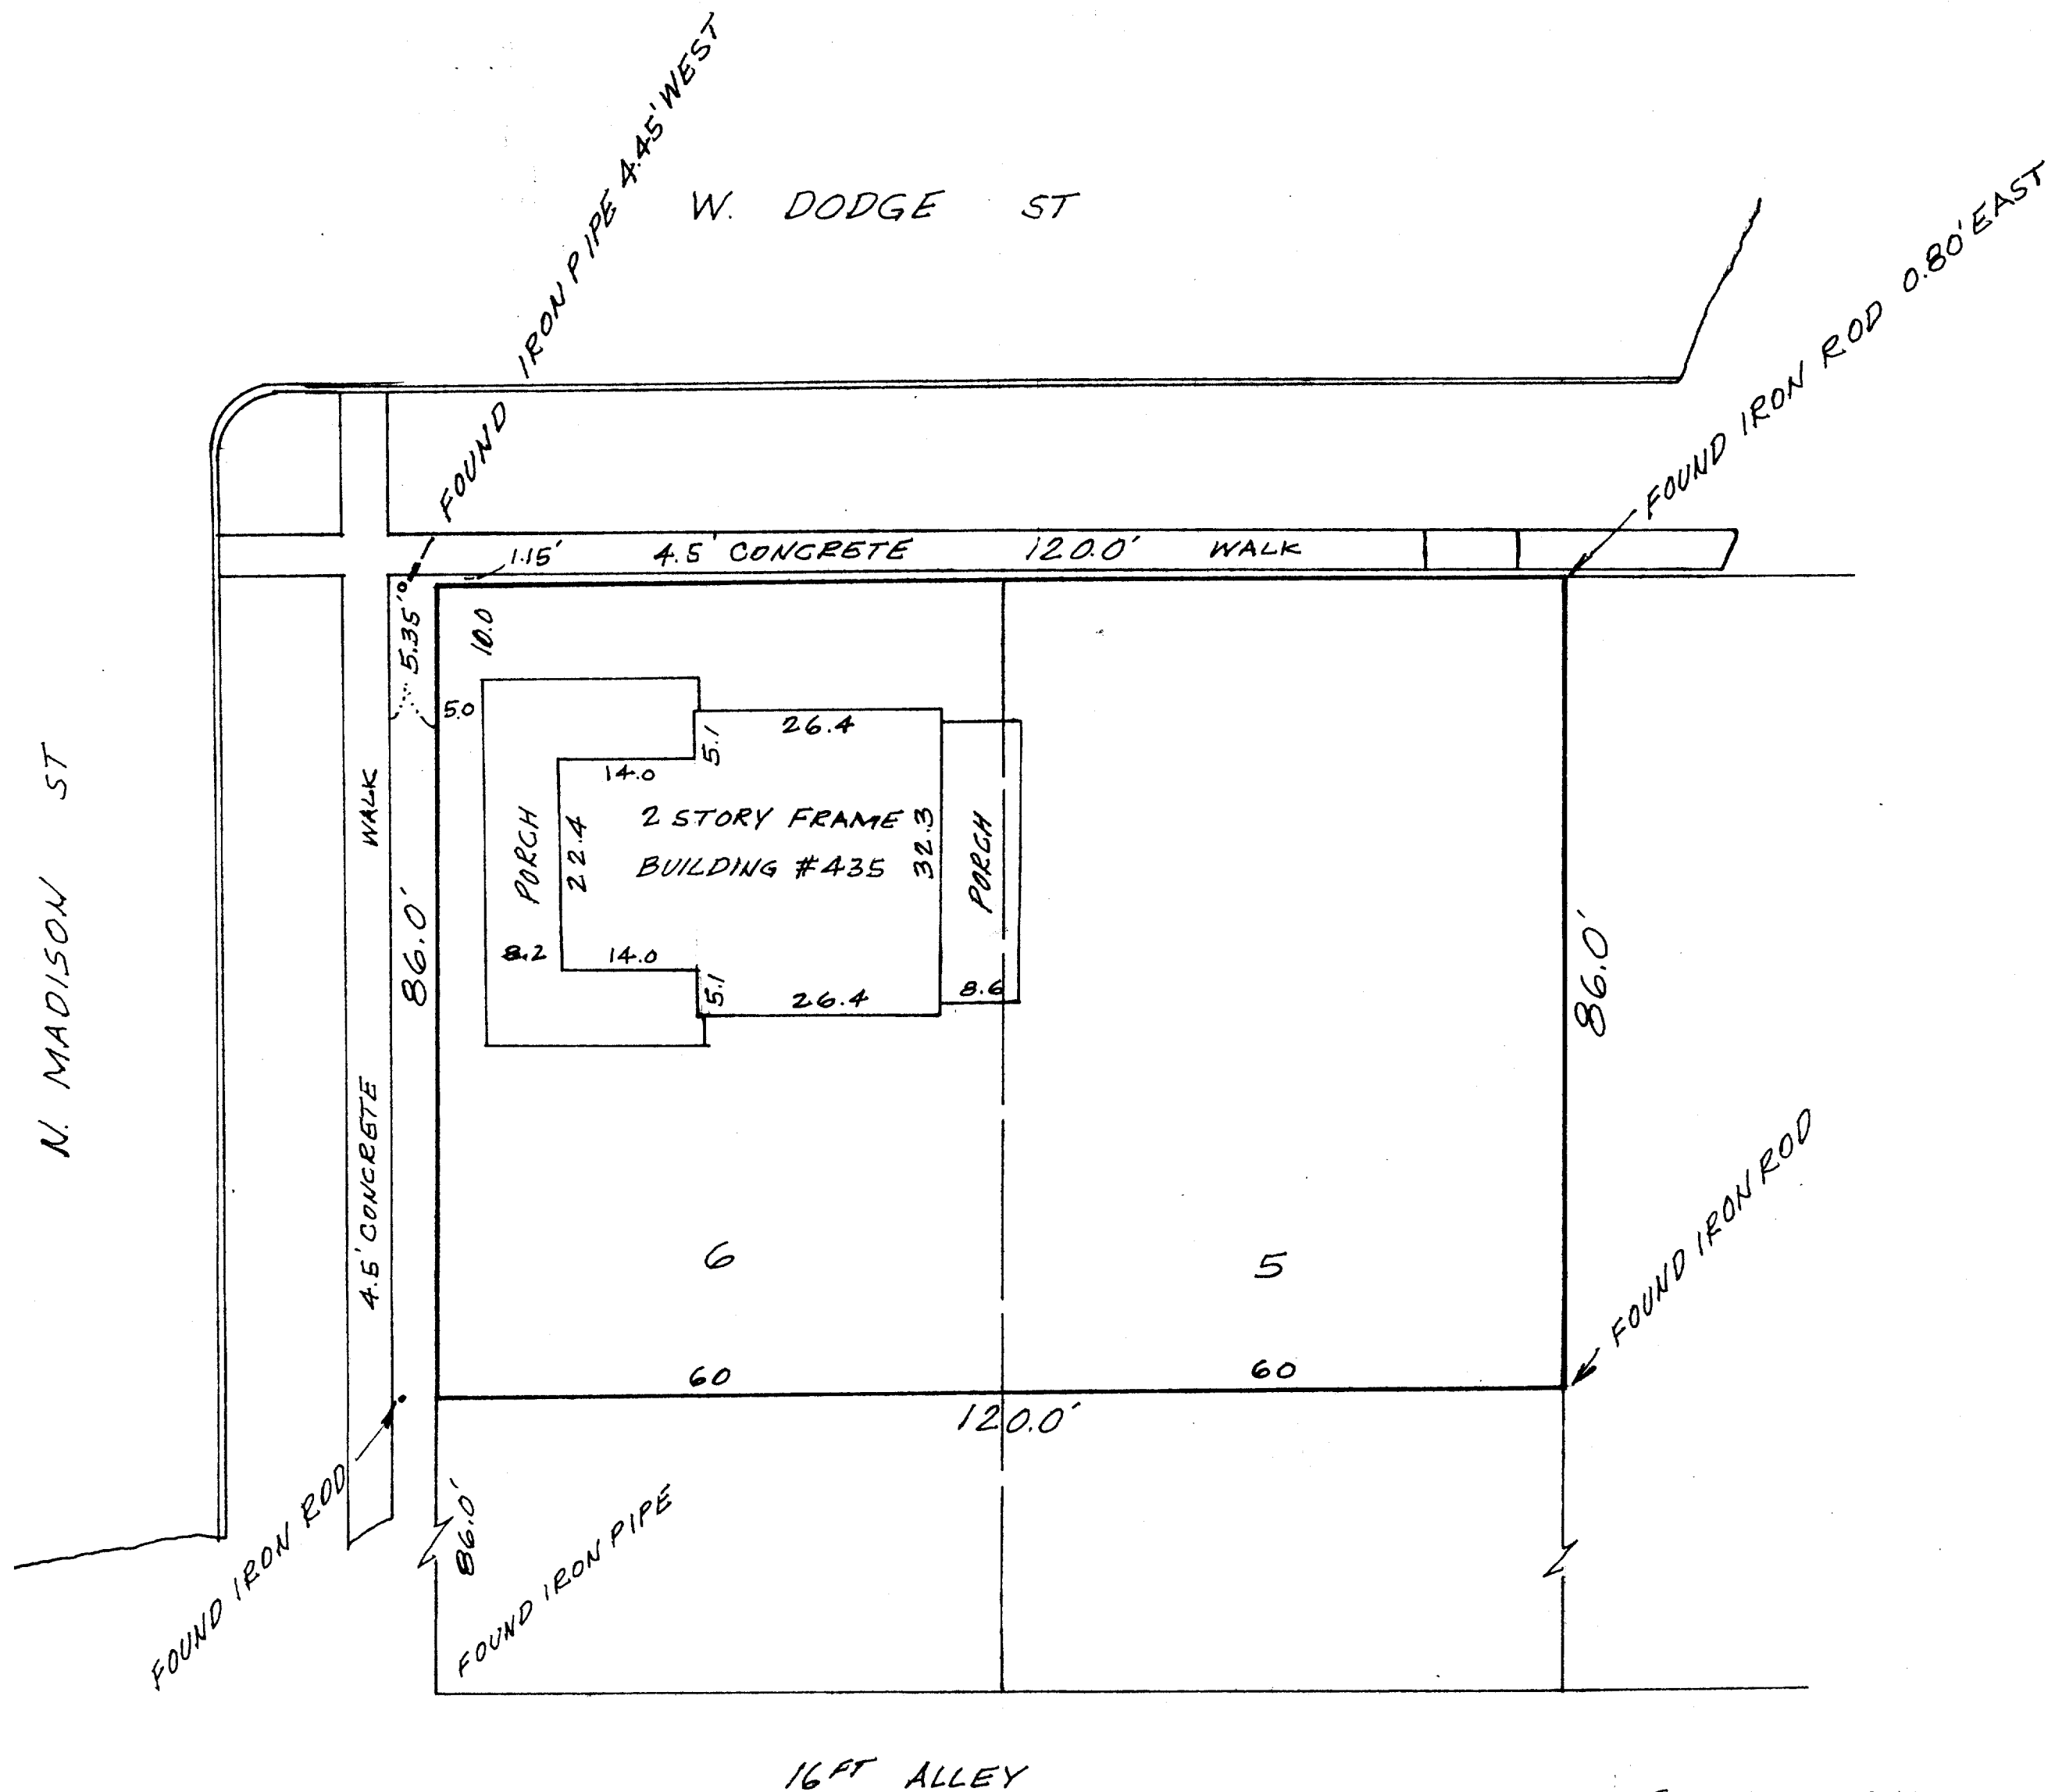

DATE SEPTEMBER 12, 1991

STATE OF WISCONSIN) ss
WALWORTH COUNTY) ss

Charles E. Smith hereby certifies
that he has surveyed the above
described property and that the
plat hereon drawn is a correct
representation of same.

Charles E. Smith

Wisconsin Registered
Land Surveyor No. S1038


ORDER NO 206

ORDERED BY: Les Johnson of ReMax
FIELD BOOK : 3 PAGE 47

All dimensions are given in feet and
decimal parts thereof and are correct
at 68° Fahrenheit.

NOTE: Any discrepancy in measurement
discovered upon the ground should
be promptly reported to the surveyor
for explanation or correction.

CHARLES E. SMITH, SURVEYOR
1544 W. MAIN ST - LAKE GENEVA
414-248-9423

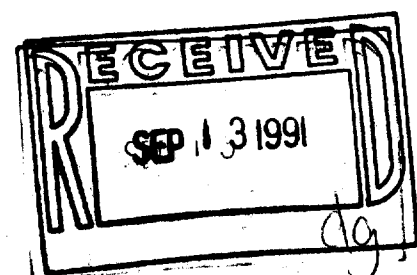

SCALE:	DATE:	APPROVED BY:	DRAWN BY:	REVIEWED:	DRAWING NUMBER:

207-1243

ZOP 000910