


52-24

2001-17

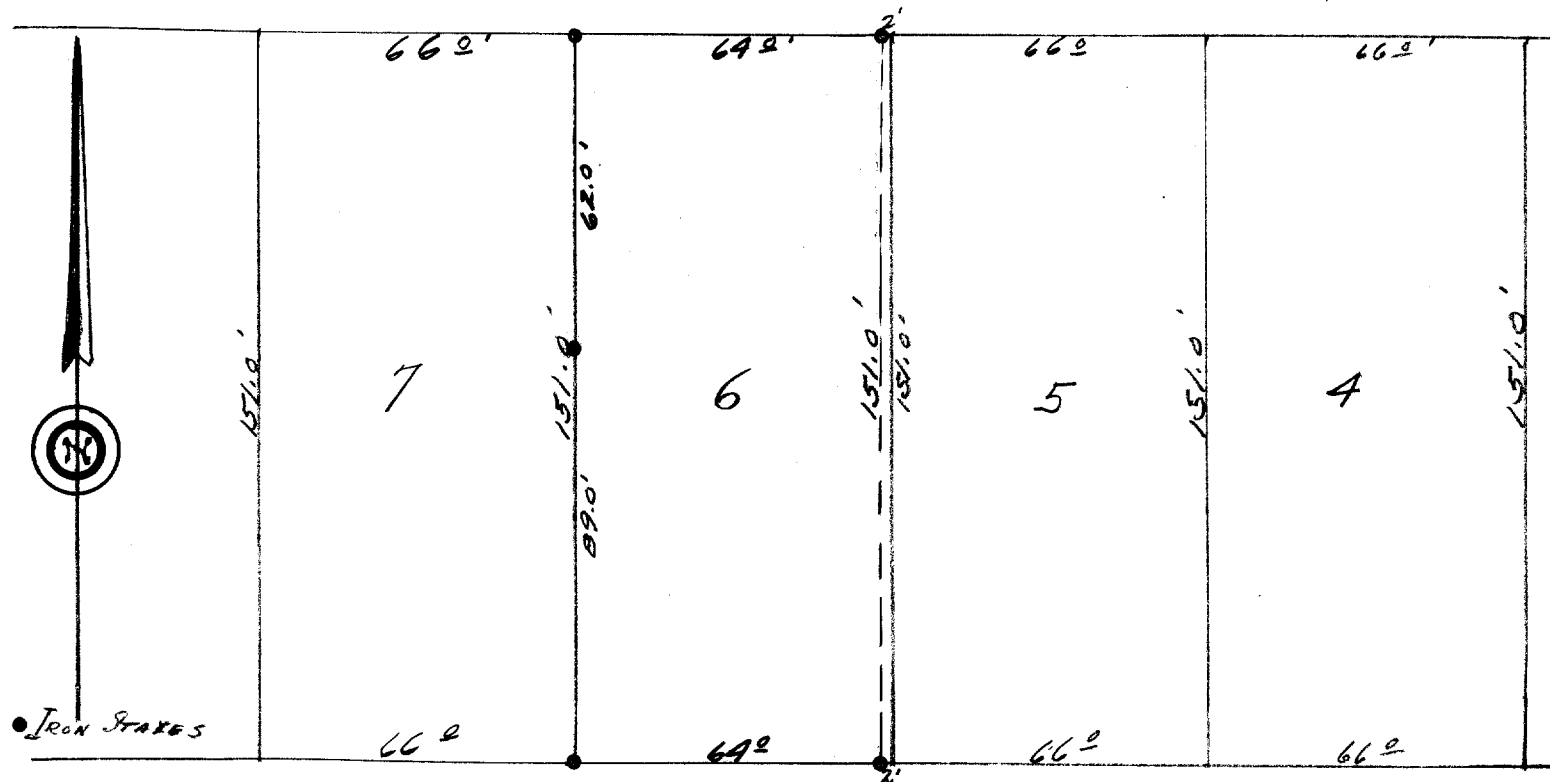

HENRY ST.

DESCRIPTION:

The West 64 feet of Lot 6, Rich's Addition to the City of Lake Geneva, Walworth County, Wisconsin.

CERTIFICATE:

I, hereby certify that, I have on this the 26th day of July 1952, surveyed the above described property, according to the official record, and find that no encroachments exist and that the plat here shown is a correct representation of said survey.

SIGNED AND SEALED THIS 30th day of July 1952.

Joseph M. Biagi
Joseph M. Biagi, Professional Engineer
Elkhorn Wisconsin.

RA-5

7-125B