

KOLB LAND CONSULTING, INC.
LAND SURVEYING • SUBDIVIDING • LAND PLANNING


LAKE GENEVA, WISCONSIN 53147

WHITEWATER, WISCONSIN 53190

LAURIE STREET - 50' WIDE

DORWOOD DRIVE - 50' WIDE

BONNIE BRAE LANE - 50' WIDE

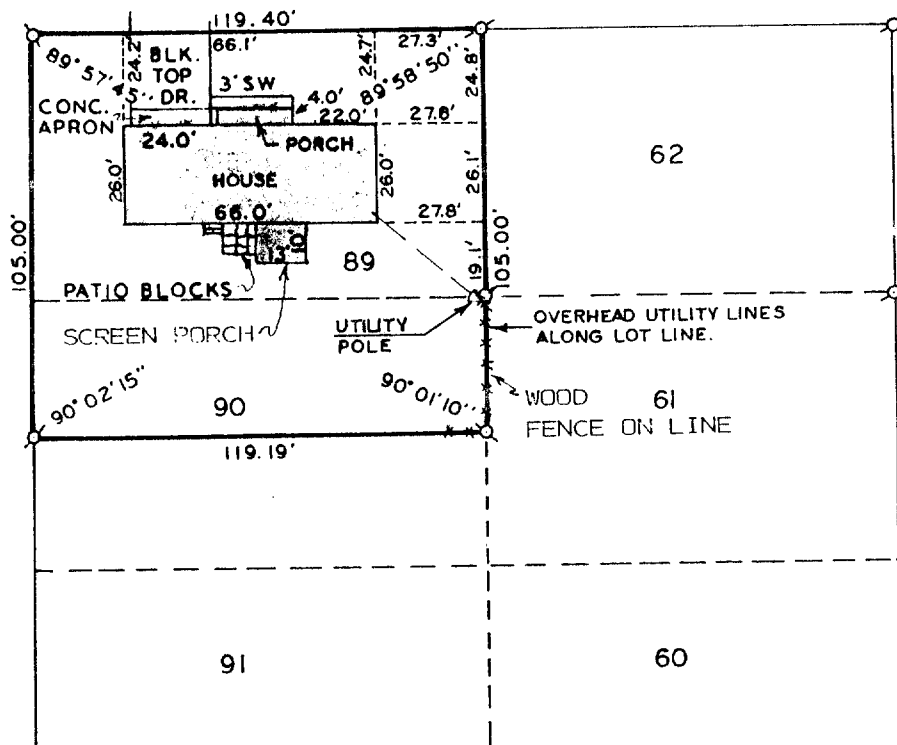


NOTE: SURVEY NOT VALID UNLESS
SURVEYOR'S SIGNATURE IS IN RED.

PLAT OF SURVEY OF

LOT 89 AND THE NORTH 1/2 OF LOT 90, H. E.
WELLS ADDITION TO THE CITY OF LAKE GENEVA,
WALWORTH COUNTY, WISCONSIN.

ORDERED BY: REDELL REALTY
6-29-90 ROUTE 5, BOX 1074
LAKE GENEVA, WI. 53147

ORDERED BY: CARL L. WOODWARD
750 WELLS STREET
LAKE GENEVA, WI 53147

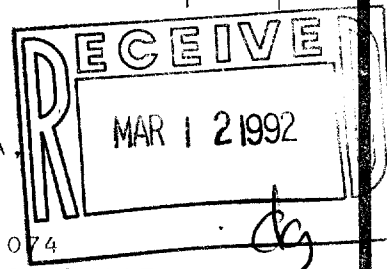

SCALE: 1"=50'

LEGEND
ø - IRON PIPE FOUND
o - IRON PIPE SET
SW- SIDE WALK
--- OVERHEAD UTILITY LINES

I HEREBY CERTIFY THAT I HAVE SURVEYED THE ABOVE
DESCRIBED PROPERTY AND THAT THE ABOVE MAP IS A
TRUE REPRESENTATION THEREOF AND SHOWS THE SIZE
AND LOCATION OF THE PROPERTY, ITS EXTERIOR
BOUNDARIES, THE LOCATION OF ALL VISIBLE
STRUCTURES AND DIMENSIONS OF ALL PRINCIPAL
BUILDINGS THEREON, BOUNDARY FENCES, APPARENT
EASEMENTS, ROADWAYS AND VISIBLE ENCROACHMENTS,
IF ANY.

THIS SURVEY IS MADE FOR THE USE OF THE PRESENT
OWNERS OF THE PROPERTY, AND ALSO THOSE WHO
PURCHASE, MORTGAGE, OR GUARANTEE THE TITLE
THERETO WITHIN ONE (1) YEAR FROM DATE HEREOF.

Harold H. Kolb

HAROLD H. KOLB
WISCONSIN REGISTERED LAND SURVEYOR, S-187

DATE Nov. 19, 1979

REVISED JUNE 29, 1990

007-1352

ZWE-89 LG-112